

City of Prince George

HISTORY SHEET

PID: 028904869

Scale: 1:500

Legal: LOT 30

D.L.: 905

PLAN: EPP17616

Address: 2638 CHANCELLOR BOULEVARD

Sanitary Connection:# SIZE: 100mmØ MATERIAL: PVC INV. AT R 716.08m CONNECTED

Water Connection:# SIZE: 19mmØ MATERIAL: Copper INV. AT R 716.08m

Storm Connection:# SIZE: 100mmØ MATERIAL: PVC INV. AT R 716.08m CONNECTED

Cash Receipt No's: WATER SANITARY STORM

CURB FROM PROPERTY LINE 6m PAVEMENT WIDTH 13m

HYDRO 75mm DB2 U/G CONNECTION ✓


TELEPHONE 100mm DB2 U/G CONNECTION ✓

GAS 42 PROP/P.E.

Information Sheets: REF. DWGS. L&M ENGINEERING LTD. JOB. 1273-14-04 DWGS.

Comments: CS CURB STOP CO CLEAN OUT SOW WATER SERVICE SOW STORM SERVICE SOW SANITARY SERVICE HYDRO SERVICE CABLE SERVICE TELECOMMUNICATIONS GAS ELECTRICAL

THE INFORMATION CONTAINED HEREIN IS FOR INTERNAL USE ONLY.
NOT TO BE RELIED UPON UNLESS CONFIRMED BY THE SITE INSPECTION AND/OR INVESTIGATION

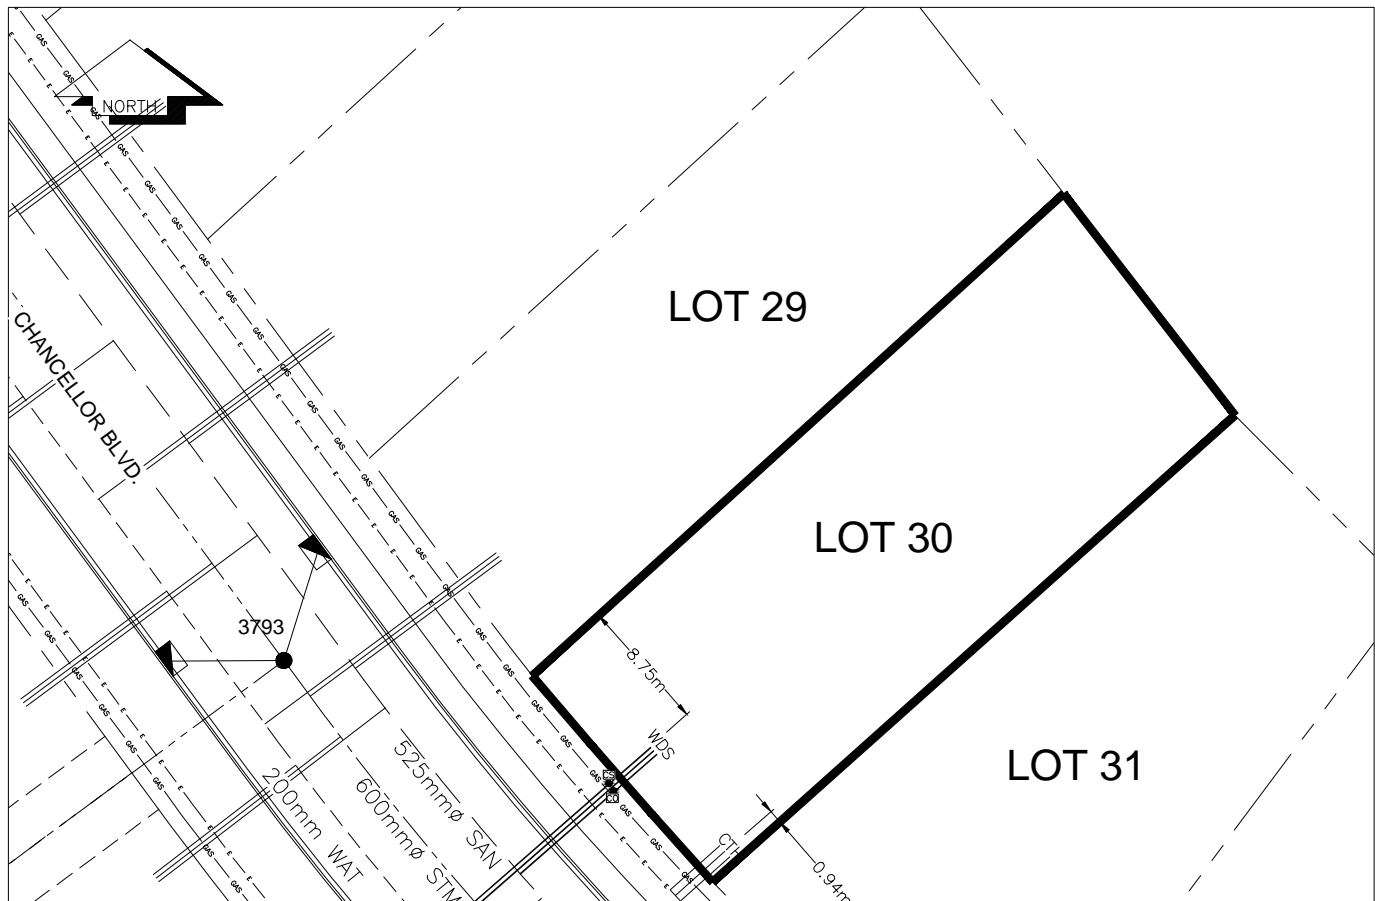

SANITARY, STORM & WATER SERVICE INVERTS	SANITARY	WATER	STORM
1. Distance from San. M.H. <u>5233</u> toward San. M.H. <u>5232</u> to lot service connection point is:	93.64m	N/A	N/A
1a.Distance from Stm. M.H. <u>3791</u> toward Stm. M.H. <u>3790</u> to lot service connection point is:	N/A	N/A	22.11m
2. Main Size at connection point is	525mmØ	200mmØ	600mmØ
3. Invert of service at main conn. stub point is	715.54m	715.30m	715.28m
4. Invert at service end is	716.38m	716.36m	716.39m
5. Cover at property line in meters	2.24m	2.32m	2.24m
6. Survey Date: MAY 2012 Book Ref.:1273-14-04 By: L&M ENGINEERING LTD			

SANITARY HISTORY:

DATE INSTALLED: JULY 2012

INSTALLED BY: SUNLAND UTILITIES LTD

WATER HISTORY:

DATE INSTALLED: JULY 2012

INSTALLED BY: SUNLAND UTILITIES LTD.

STORM HISTORY:

DATE INSTALLED: JULY 2012

INSTALLED BY: SUNLAND UTILITIES LTD.