



# City of Prince George History Sheet

PID:	028985176
SD/MU:	
WO:	

Civic Address: 2396 Regents Cres

Legal Description: Lot: B Block: 24 (B83003967) District Lot: 417 Plan: 1409


Service Type	Diameter (mm)	Material	Invert Elev at main (m)	Invert Elev at property line (m)	Invert Elev at service end (m)	Distance into property (m)	Installation Date
Sanitary	100mm	PVC	-	-	-	-	January 1971
Water	20mm	Copper	-	-	-	-	January 1955
Storm	N/A	N/A	-	-	-	-	

Service Connection Location					Sanitary (m)	Storm (m)
Distance from downstream San MH	1106	towards upstream San MH	1734		48.90	
Distance from downstream Stm MH	-	towards upstream Stm MH	-			

Power	Size	Communications	Size	Cable	Size	Gas	Size
BC Hydro	-	Telus	-	Shaw	-	FortisBC	-
Overhead Service		Overhead Service		Overhead Service			

Installed by:		Survey Date:	-
Comments:	Upon consolidation the southern set of services were abandoned.		

**NOT TO SCALE** The information contained herein is for internal use only.  
Not to be relied on unless confirmed by site inspection and/or investigation.

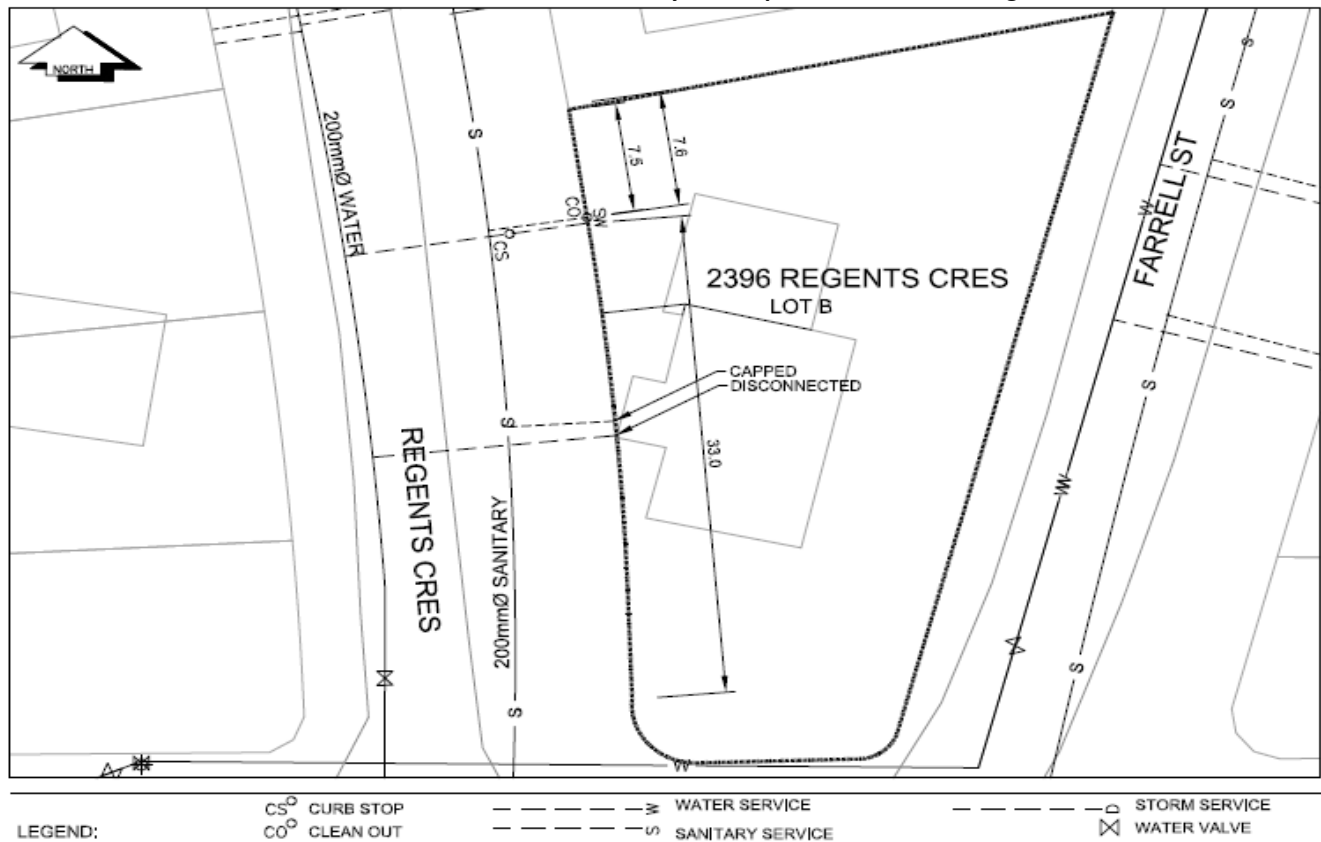

**NOT TO SCALE**