



City of Prince George History Sheet

| | |
|--------|-----------|
| PID: | 028985656 |
| SD/MU: | |
| WO: | |

Civic Address: 841 Central Street

Legal Description: Lot: 1 District Lot: 936 Plan: EPP21547


| Service Type | Diameter (mm) | Material | Invert Elev at main (m) | Invert Elev at property line (m) | Depth at property (m) | Distance into property (m) | Installation Date |
|--------------|---------------|----------|-------------------------|----------------------------------|-----------------------|----------------------------|-------------------|
| Sanitary | 150mm | AC | - | 597.43 | 2.19 | - | July 1968 |
| Water | 40mm | Copper | - | - | - | - | |
| Storm | 200mm | Unknown | - | 599.27 | 1.31 | - | July 1968 |

| Service Connection Location | | | | | Sanitary (m) | Storm (m) |
|---------------------------------|------|-------------------------|------|--|--------------|-----------|
| Distance from downstream San MH | 1958 | towards upstream San MH | 1953 | | 60.68 | |
| Distance from downstream Stm MH | 2116 | towards upstream Stm MH | 2077 | | | 45.52 |

| Power | Size | Communications | Size | Cable | Size | Gas | Size |
|------------------|------|------------------|------|------------------|------|----------|------|
| BC Hydro | - | Telus | - | Shaw | - | FortisBC | - |
| Overhead Service | | Overhead Service | | Overhead Service | | | |

| | | |
|---------------|--------------|---|
| Installed by: | Survey Date: | - |
| Comments: | | |
| | | |
| | | |

NOT TO SCALE The information contained herein is for internal use only.
Not to be relied on unless confirmed by site inspection and/or investigation.

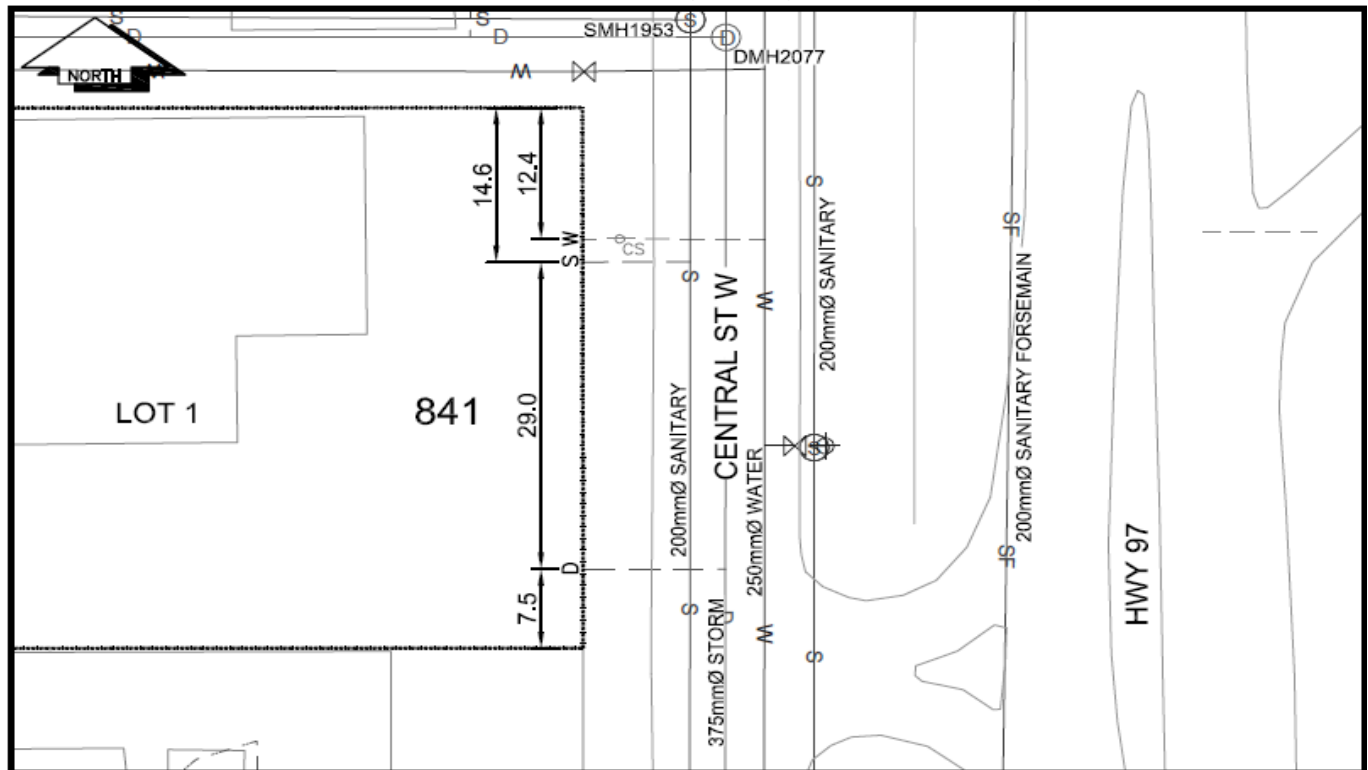

| | | | |
|---------|--------------|------------------------|---------------------|
| LEGEND: | CS CURB STOP | --- W WATER SERVICE | --- D STORM SERVICE |
| | CO CLEAN OUT | --- S SANITARY SERVICE | --- G GAS |

NOT TO SCALE