



# City of Prince George History Sheet

PID:	028999819
SD:	100397
WO:	

Civic Address: 2987 Charella Dr

Legal Description: Lot: 1 District Lot: 9261 Plan: EPP23369


Service Type	Diameter (mm)	Material	Invert Elev at main (m)	Depth of cut at property line (m)	Invert Elev at service end (m)	Distance into property (m)	Installation Date
Sanitary	100mm	PVC	-	2.79	-	-	January 1980
Water	20mm	Copper	-	-	-	-	
Storm	N/A	N/A	-	-	-	-	

Service Connection Location				Sanitary (m)	Storm (m)
Distance from downstream San MH	3615	towards upstream San MH	3564	48.90	
Distance from downstream Stm MH	-	towards upstream Stm MH	-		-

Power	Size	Communications	Size	Cable	Size	Gas	Size
BC Hydro	-	Telus	-	Shaw	-	FortisBC	-
Overhead Service		Overhead Service		Overhead Service			

Installed by:	Survey Date:	-
Comments:		

**NOT TO SCALE** The information contained herein is for internal use only.  
Not to be relied on unless confirmed by site inspection and/or investigation.

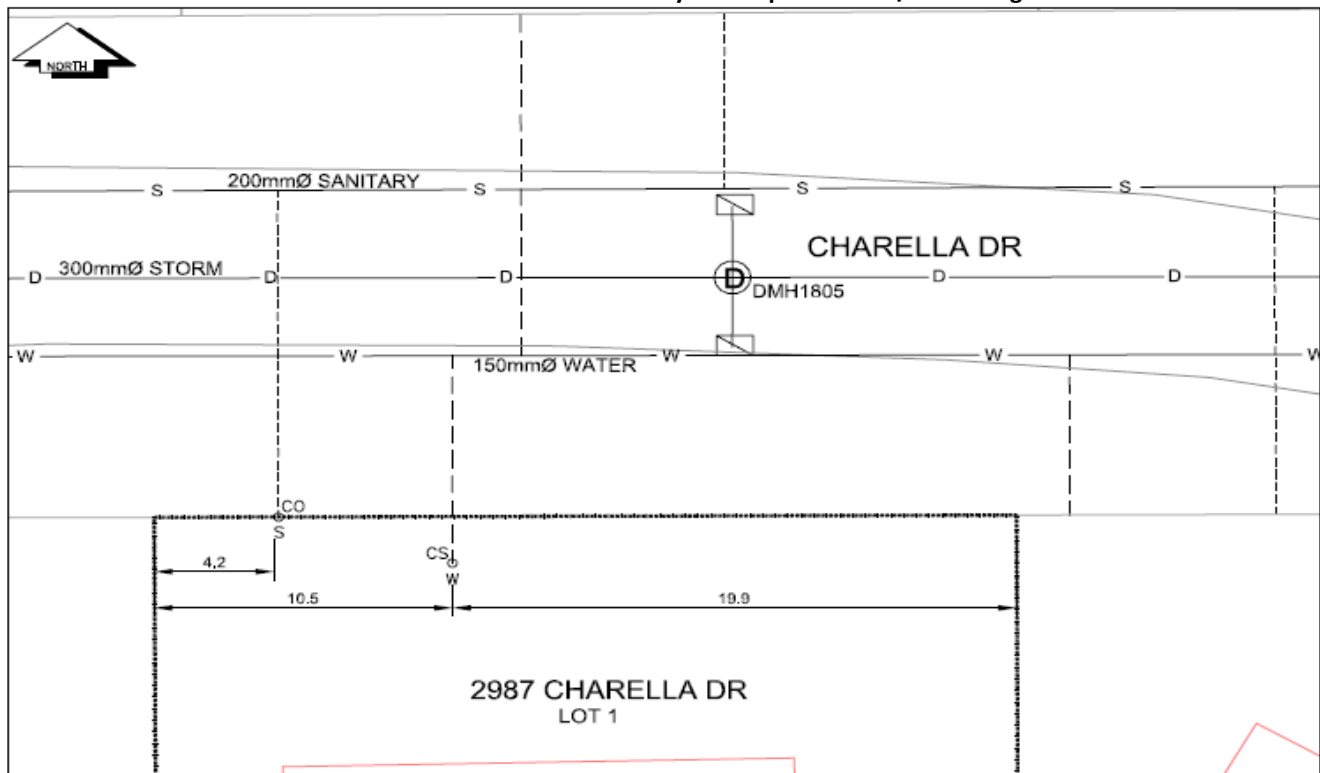

LEGEND:	CS <sup>o</sup> CURB STOP	--- W WATER SERVICE	--- S SANITARY SERVICE	--- D STORM SERVICE	⊗ WATER VALVE
	CO <sup>o</sup> CLEAN OUT				

**NOT TO SCALE**