



City of Prince George
History Sheet

PID:	028999827
SD	100397
WO:	

Civic Address: 2967 Charella Dr

Legal Description: Lot: 2 District Lot: 9261 Plan: EPP23369


Service Type	Diameter (mm)	Material	Invert Elev at main (m)	Invert Elev at property line (m)	Invert Elev at service end (m)	Distance into property (m)	Installation Date
Sanitary	100mm	PVC	-	-	-	-	-
Water	20mm	Copper	-	-	-	-	-
Storm	100mm	PVC	-	-	-	-	-

Service Connection Location				Sanitary (m)	Storm (m)
Distance from downstream San MH	2622	towards upstream San MH	3615	11.40	
Distance from downstream Stm MH	1801	towards upstream Stm MH	1802		8.88

Power	Size	Communications	Size	Cable	Size	Gas	Size
BC Hydro	-	Telus	-	Shaw	-	FortisBC	-
Overhead Service		Overhead Service		Overhead Service			

Installed by:	City of Prince George forces	Survey Date:	-
Comments:			

NOT TO SCALE The information contained herein is for internal use only.
Not to be relied on unless confirmed by site inspection and/or investigation.

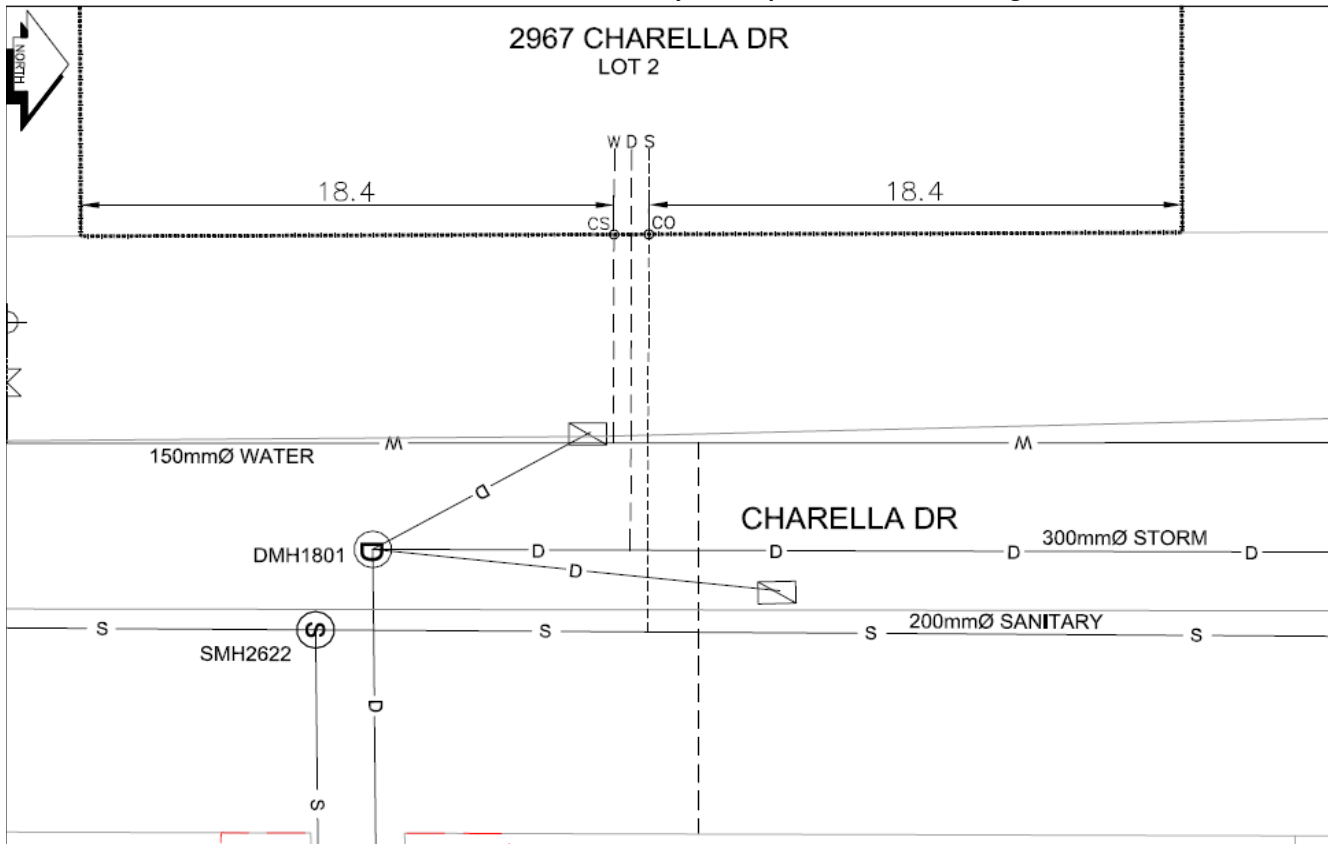

LEGEND:	CS CURB STOP	--- W WATER SERVICE	--- S STORM SERVICE
	CO CLEAN OUT	--- S SANITARY SERVICE	⊗ WATER VALVE

NOT TO SCALE