



City of Prince George History Sheet

PID:	029026806
SD/MU:	
WO:	

Civic Address: 1706 Ogilvie St

Legal Description: Lot: A District Lot: 936 Plan: EPP28433


Service Type	Diameter (mm)	Material	Invert Elev at main (m)	Sept of cut at property line (m)	Invert Elev at service end (m)	Distance into property (m)	Installation Date
Sanitary	100mm	PVC	-	2.10	602.12	-	January 1971
Water	20mm	Copper	-	-	-	-	
Storm	N/A	N/A	-	-	-	-	

Service Connection Location				Sanitary (m)	Storm (m)
Distance from downstream San MH	836	towards upstream San MH	4036	76.60	
Distance from downstream Stm MH	-	towards upstream Stm MH	-		

Power	Size	Communications	Size	Cable	Size	Gas	Size
BC Hydro	-	Telus	-	Shaw	-	FortisBC	-
Overhead Service		Overhead Service		Overhead Service			

Installed by:	Survey Date:	-
Comments:		

NOT TO SCALE The information contained herein is for internal use only.
Not to be relied on unless confirmed by site inspection and/or investigation.

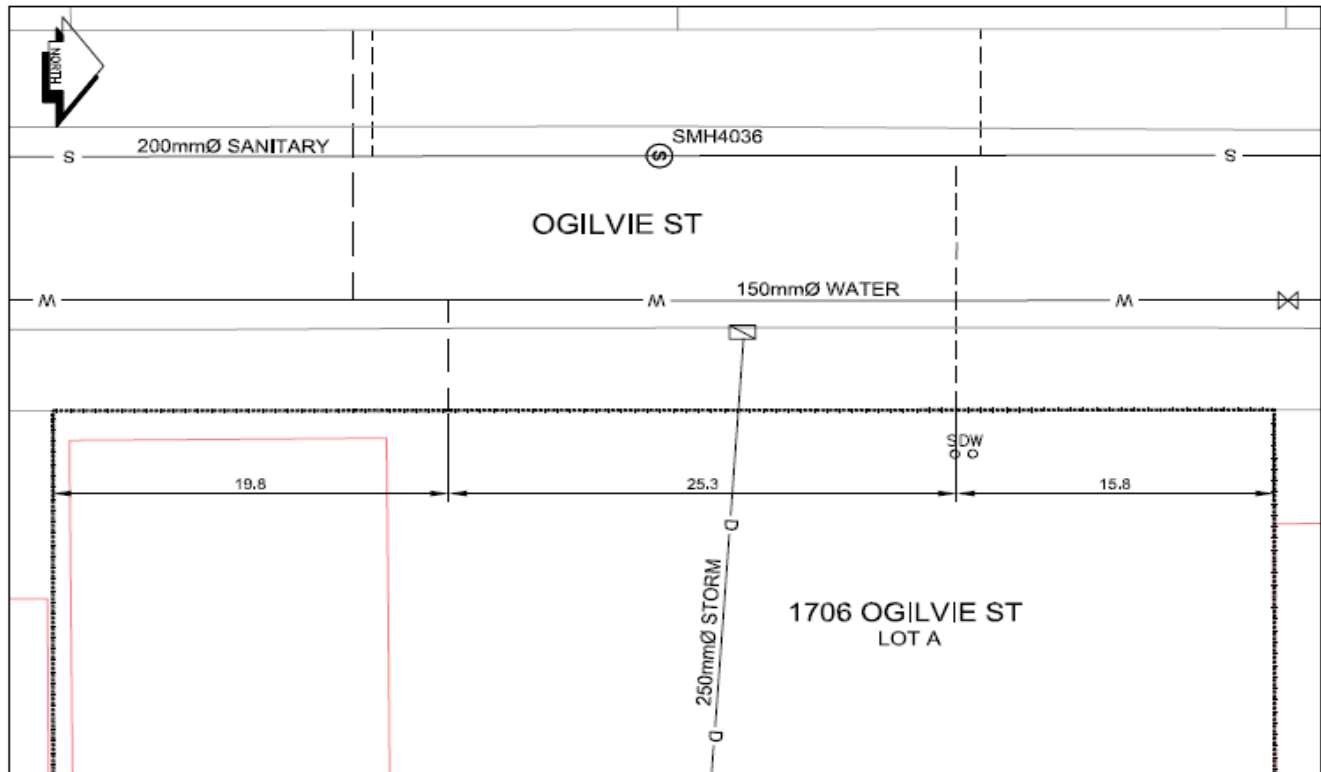

CS	CURB STOP	---	WATER SERVICE	---	STORM SERVICE
CO	CLEAN OUT	---	SANITARY SERVICE	⊗	WATER VALVE

NOT TO SCALE