



City of Prince George
History Sheet

PID:	029028493
SD:	100405
WO:	

Civic Address: 7448 Creekside Way

Legal Description: Lot: B District Lot: 2014 Plan: EPP27228


Service Type	Diameter (mm)	Material	Invert Elev at main (m)	Depth of cut at property line (m)	Invert Elev at service end (m)	Distance into property (m)	Installation Date
Sanitary	100mm	PVC	582.09	2.67	584.18	3.00	October 2009
Water	20mm	Copper	583.49	2.62	584.31	3.00	October 2009
Storm	100mm	PVC	582.67	2.66	584.19	3.00	October 2009

Service Connection Location				Sanitary (m)	Storm (m)
Distance from downstream San MH	5138	towards upstream San MH	5139	2.00	
Distance from downstream Stm MH	3659	towards upstream Stm MH	3658		3.00

Power	Size	Communications	Size	Cable	Size	Gas	Size
BC Hydro	75mm DB2	Telus	50mm DB2	Shaw	-	FortisBC	42Prop/P.E.
Underground Service		Underground Service		Underground Service			

Installed by:	Fortwood Homes Ltd	Survey Date:	-
Comments:			

NOT TO SCALE The information contained herein is for internal use only.
Not to be relied on unless confirmed by site inspection and/or investigation.

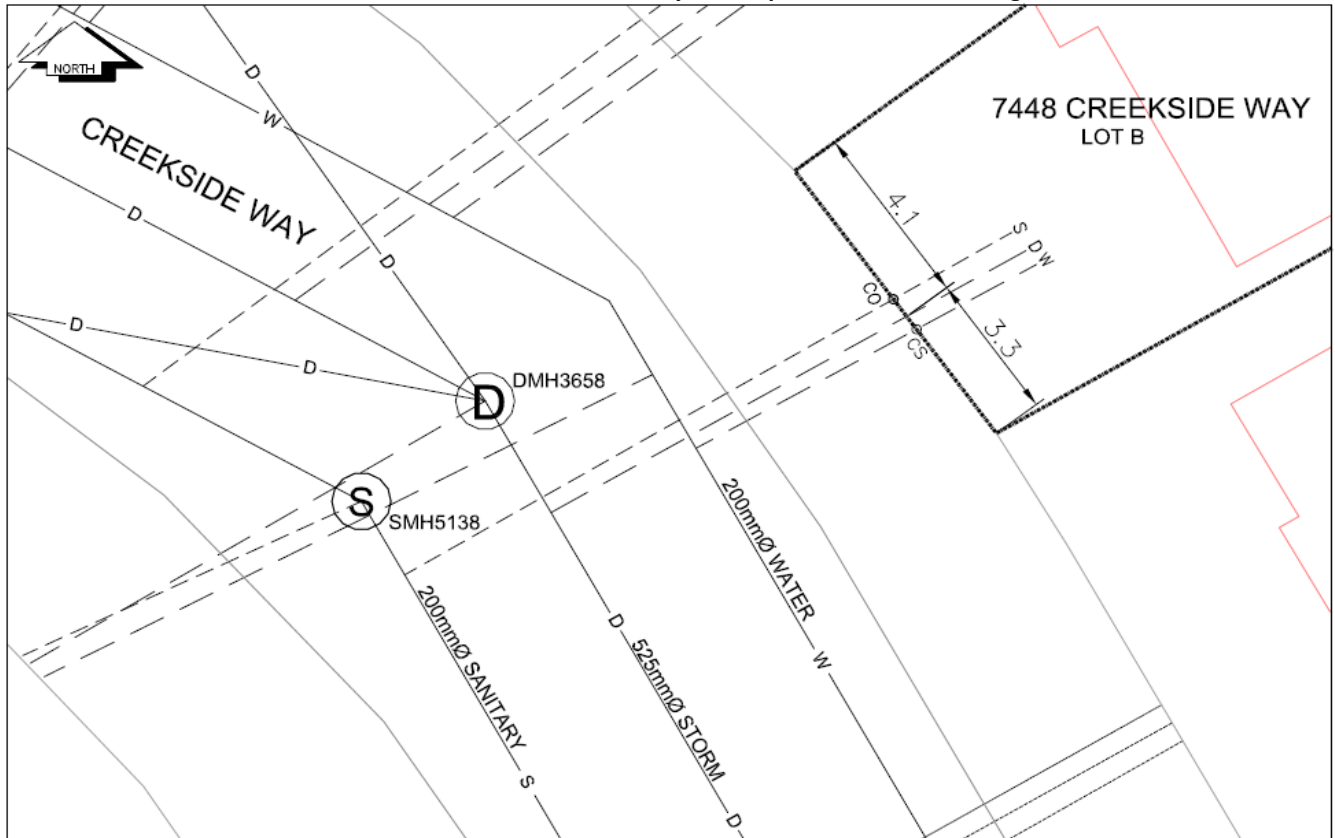

LEGEND:	CS	CURB STOP	---	W	WATER SERVICE	---	---	STORM SERVICE
	CO	CLEAN OUT	---	S	SANITARY SERVICE	---	---	WATER VALVE

NOT TO SCALE