



City of Prince George
History Sheet

PID:	029038383
SD:	100392
WO:	

Civic Address: 2692 Marleau Rd

Legal Description: Lot: A District Lot: 754 Plan: EPP23493


Service Type	Diameter (mm)	Material	Invert Elev at main (m)	Depth of cut at property line (m)	Invert Elev at service end (m)	Distance into property (m)	Installation Date
Sanitary	100mm	PVC	-	2.76	-	-	January 1994
Water	20mm	Copper	-		-	-	January 1994
Storm	100mm	PVC	-	2.68	645.24	-	January 1994

Service Connection Location				Sanitary (m)	Storm (m)
Distance from downstream San MH	4199	towards upstream San MH	4200	9.76	
Distance from downstream Stm MH	875	towards upstream Stm MH	876		16.31

Power	Size	Communications	Size	Cable	Size	Gas	Size
BC Hydro	-	Telus	-	Shaw	-	FortisBC	-
Overhead Service		Overhead Service		Overhead Service			

Installed by:		Survey Date:	-
Comments:			

NOT TO SCALE The information contained herein is for internal use only.
Not to be relied on unless confirmed by site inspection and/or investigation.

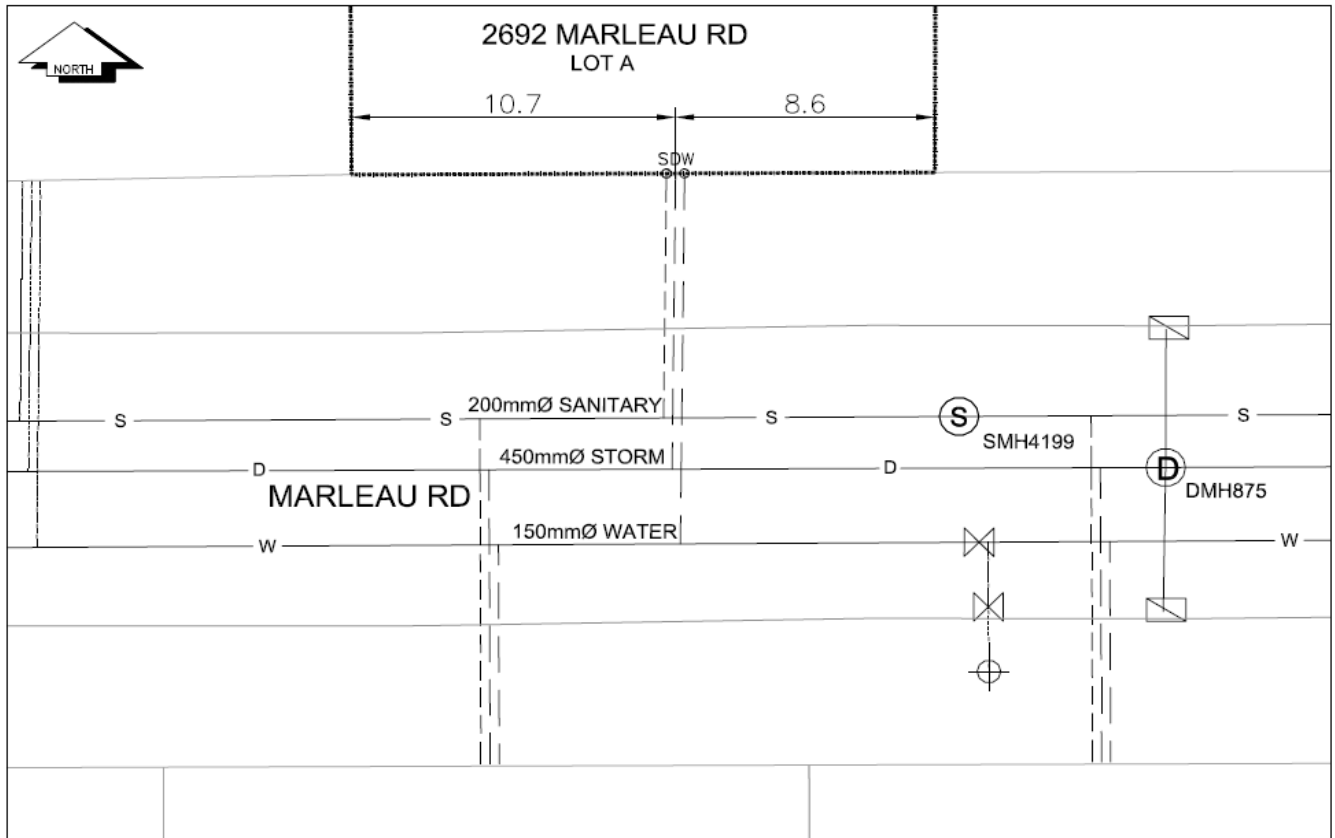

LEGEND:	CS CURB STOP	--- W WATER SERVICE	--- S STORM SERVICE
	CO CLEAN OUT	--- S SANITARY SERVICE	X WATER VALVE

NOT TO SCALE