



City of Prince George
History Sheet

PID:	029039321
SD:	100338
WO:	49859

Civic Address: 3755 Balsum Rd

Legal Description: Lot: 1 District Lot: 4047 Plan: EPP13663


Service Type	Diameter (mm)	Material	Invert Elev at main (m)	Depth of cut at property line (m)	Invert Elev at service end (m)	Distance into property (m)	Installation Date
Sanitary	100mm	PVC	-	2.63	737.07	-	July 2011
Water	20mm	Copper	-	-	-	-	November 2009
Storm	N/A	N/A	-	-	-	-	

Service Connection Location				Sanitary (m)	Storm (m)
Distance from downstream San MH	435	towards upstream San MH	434	74.65	
Distance from downstream Stm MH	-	towards upstream Stm MH	-		

Power	Size	Communications	Size	Cable	Size	Gas	Size
BC Hydro	-	Telus	-	Shaw	-	FortisBC	-
Overhead Service		Overhead Service		Overhead Service			

Installed by:	City of Prince George forces	Survey Date:	-
Comments:	Location confirmed September 2016		

NOT TO SCALE The information contained herein is for internal use only.
Not to be relied on unless confirmed by site inspection and/or investigation.

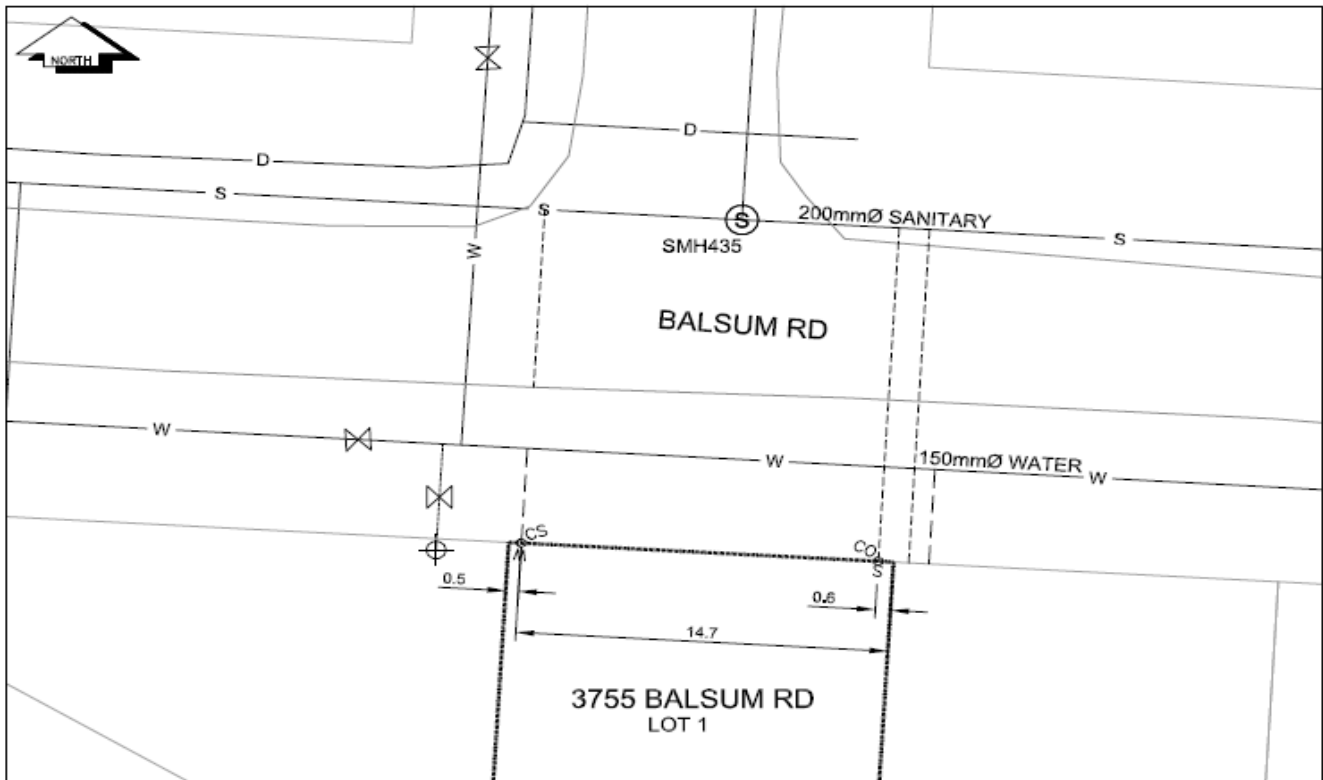

LEGEND:	CS CURB STOP	--- W WATER SERVICE	--- S STORM SERVICE
	CO CLEAN OUT	--- S SANITARY SERVICE	⊗ WATER VALVE

NOT TO SCALE