



City of Prince George History Sheet

PID:	029039339
SD/MU:	100338/101192
WO:	59626/59627

Civic Address: 3749 Balsum Rd

Legal Description: Lot: 2 District Lot: 4047 Plan: EPP13663


Service Type	Diameter (mm)	Material	Invert Elev at main (m)	Invert Elev at property line (m)	Invert Elev at service end (m)	Distance into property (m)	Installation Date
Sanitary	100mm	PVC	-	-	-	-	January 1979
Water	20mm	Copper	-	-	-	-	July 2011
Storm	N/A	N/A	-	-	-	-	

Service Connection Location				Sanitary (m)	Storm (m)
Distance from downstream San MH	436	towards upstream San MH	435	71.82	
Distance from downstream Stm MH	-	towards upstream Stm MH	-		

Power	Size	Communications	Size	Cable	Size	Gas	Size
BC Hydro	-	Telus	-	Shaw	-	FortisBC	-
Overhead Service		Overhead Service		Overhead Service			

Installed by:	City of Prince George forces	Survey Date:	-
Comments:	Service locations confirmed - September 2016		

NOT TO SCALE The information contained herein is for internal use only.
Not to be relied on unless confirmed by site inspection and/or investigation.

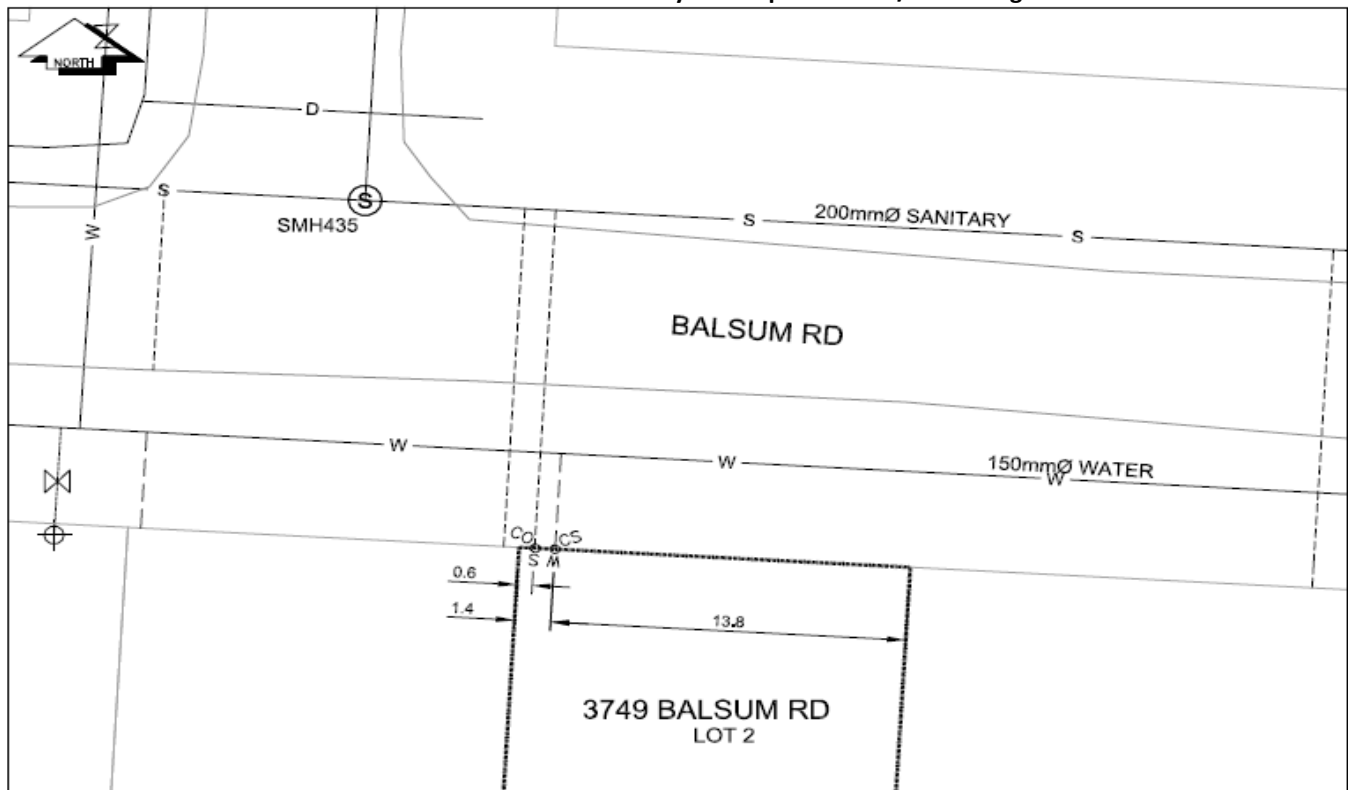

LEGEND:	CS CURB STOP	--- WATER SERVICE	--- D STORM SERVICE
	CO CLEAN OUT	--- S SANITARY SERVICE	⊗ WATER VALVE

NOT TO SCALE