



City of Prince George  
**History Sheet**

|      |           |
|------|-----------|
| PID: | 029042593 |
| SD:  | 100406    |
| WO:  |           |

Civic Address: 7587 Creekside Way

Legal Description: Lot: A District Lot: 2014 Plan: EPP28431


| Service Type | Diameter (mm) | Material | Invert Elev at main (m) | Depth of cut at property line (m) | Invert Elev at service end (m) | Distance into property (m) | Installation Date |
|--------------|---------------|----------|-------------------------|-----------------------------------|--------------------------------|----------------------------|-------------------|
| Sanitary     | 100mm         | PVC      | 582.60                  | 2.93                              | 583.25                         | -                          | October 2009      |
| Water        | 20mm          | Copper   | 582.32                  | 2.91                              | 583.35                         | -                          | October 2009      |
| Storm        | 100mm         | PVC      | 582.07                  | 2.97                              | 583.21                         | -                          | October 2009      |

| Service Connection Location     |      |                         |      | Sanitary (m) | Storm (m) |
|---------------------------------|------|-------------------------|------|--------------|-----------|
| Distance from downstream San MH | 5139 | towards upstream San MH | 5140 | 52.50        |           |
| Distance from downstream Stm MH | 2660 | towards upstream Stm MH | 3659 |              | 73.10     |

| Power               | Size | Communications      | Size | Cable               | Size | Gas      | Size         |
|---------------------|------|---------------------|------|---------------------|------|----------|--------------|
| BC Hydro            | 75mm | Telus               | 50mm | Shaw                | -    | FortisBC | 42 PROP/P.E. |
| Underground Service |      | Underground Service |      | Underground Service |      |          |              |

|               |                    |              |              |
|---------------|--------------------|--------------|--------------|
| Installed by: | Fortwood Homes Ltd | Survey Date: | October 2009 |
| Comments:     |                    |              |              |

**NOT TO SCALE** The information contained herein is for internal use only.  
Not to be relied on unless confirmed by site inspection and/or investigation.

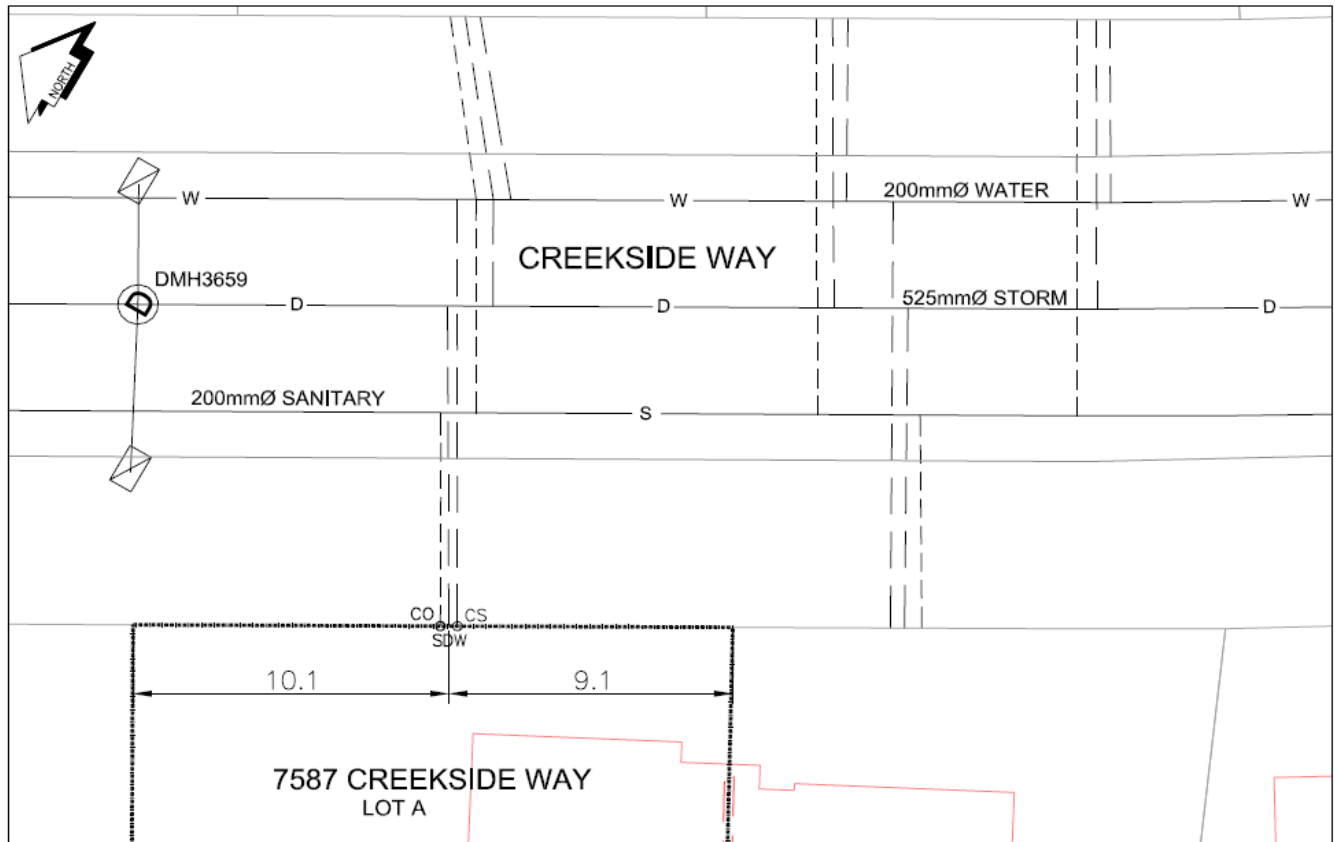

|         |                           |                      |                   |
|---------|---------------------------|----------------------|-------------------|
| LEGEND: | CS <sup>o</sup> CURB STOP | --- WATER SERVICE    | --- STORM SERVICE |
|         | CO <sup>o</sup> CLEAN OUT | --- SANITARY SERVICE | ⊗ WATER VALVE     |

**NOT TO SCALE**