



City of Prince George
History Sheet

PID:	029042607
SD:	100406
WO:	

Civic Address: 7591 Creekside Way

Legal Description: Lot: B District Lot: 2014 Plan: EPP28431


Service Type	Diameter (mm)	Material	Invert Elev at main (m)	Depth of cut at property line (m)	Invert Elev at service end (m)	Distance into property (m)	Installation Date
Sanitary	100mm	PVC	582.66	2.79	583.25	-	October 2009
Water	20mm	Copper	582.00	2.96	583.16	-	October 2009
Storm	100mm	PVC	582.02	2.81	583.23	-	October 2009

Service Connection Location				Sanitary (m)	Storm (m)
Distance from downstream San MH	5139	towards upstream San MH	5140	67.00	
Distance from downstream Stm MH	2660	towards upstream Stm MH	3659		24.00

Power	Size	Communications	Size	Cable	Size	Gas	Size
BC Hydro	75mm	Telus	50mm	Shaw	-	FortisBC	42 PROP/P.E.
Underground Service		Underground Service		Underground Service			

Installed by:	Fortwood Homes Ltd	Survey Date:	October 2009
Comments:			

NOT TO SCALE The information contained herein is for internal use only.
Not to be relied on unless confirmed by site inspection and/or investigation.

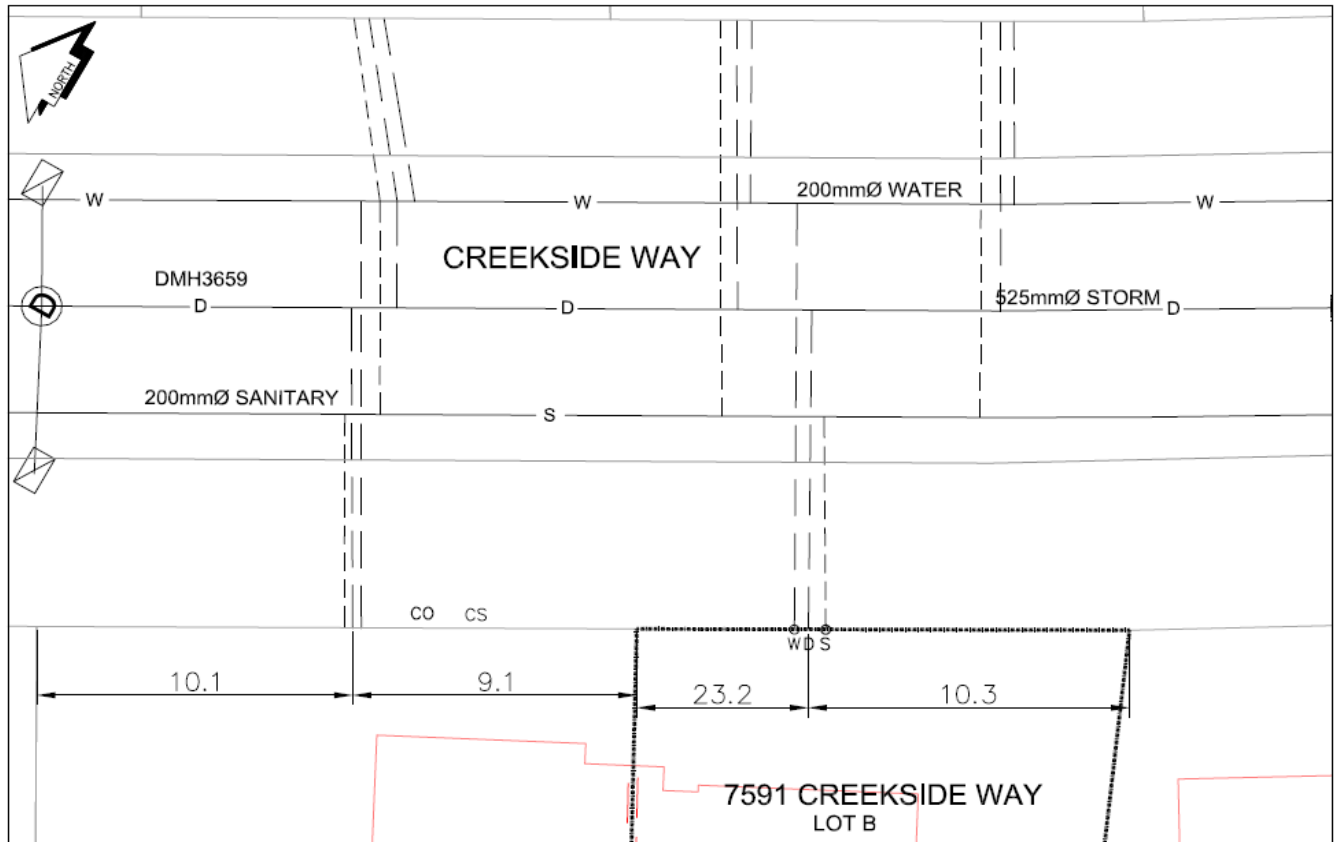

LEGEND:	CS ^o CURB STOP	--- W WATER SERVICE	--- S STORM SERVICE
	CO ^o CLEAN OUT	--- S SANITARY SERVICE	⊗ WATER VALVE

NOT TO SCALE