



City of Prince George History Sheet

PID:	029049377
SD/MU:	
WO:	72208

Civic Address: 777 Bird Ave

Legal Description: Lot: PCL C block:12 (B83006869) District Lot: 934 Plar


Service Type	Diameter (mm)	Material	Invert Elev at main (m)	Invert Elev at property line (m)	Invert Elev at service end (m)	Distance into property (m)	Installation Date
Sanitary	100mm	PVC	-	-	-	-	-
Water	20mm	Copper	-	-	-	-	-
Storm	N/A	N/A	-	-	-	-	-

Service Connection Location				Sanitary (m)	Storm (m)
Distance from downstream San MH	1106	towards upstream San MH	1107-	75.00	
Distance from downstream Stm MH	-	towards upstream Stm MH	-		

Power	Size	Communications	Size	Cable	Size	Gas	Size
BC Hydro	-	Telus	-	Shaw	-	FortisBC	-
Overhead Service		Overhead Service		Overhead Service			

Installed by:	City of Prince George forces	Survey Date:	-
Comments:	Sanitary service located July 2013. Dye test passed on October 2014		

NOT TO SCALE The information contained herein is for internal use only.
Not to be relied on unless confirmed by site inspection and/or investigation.

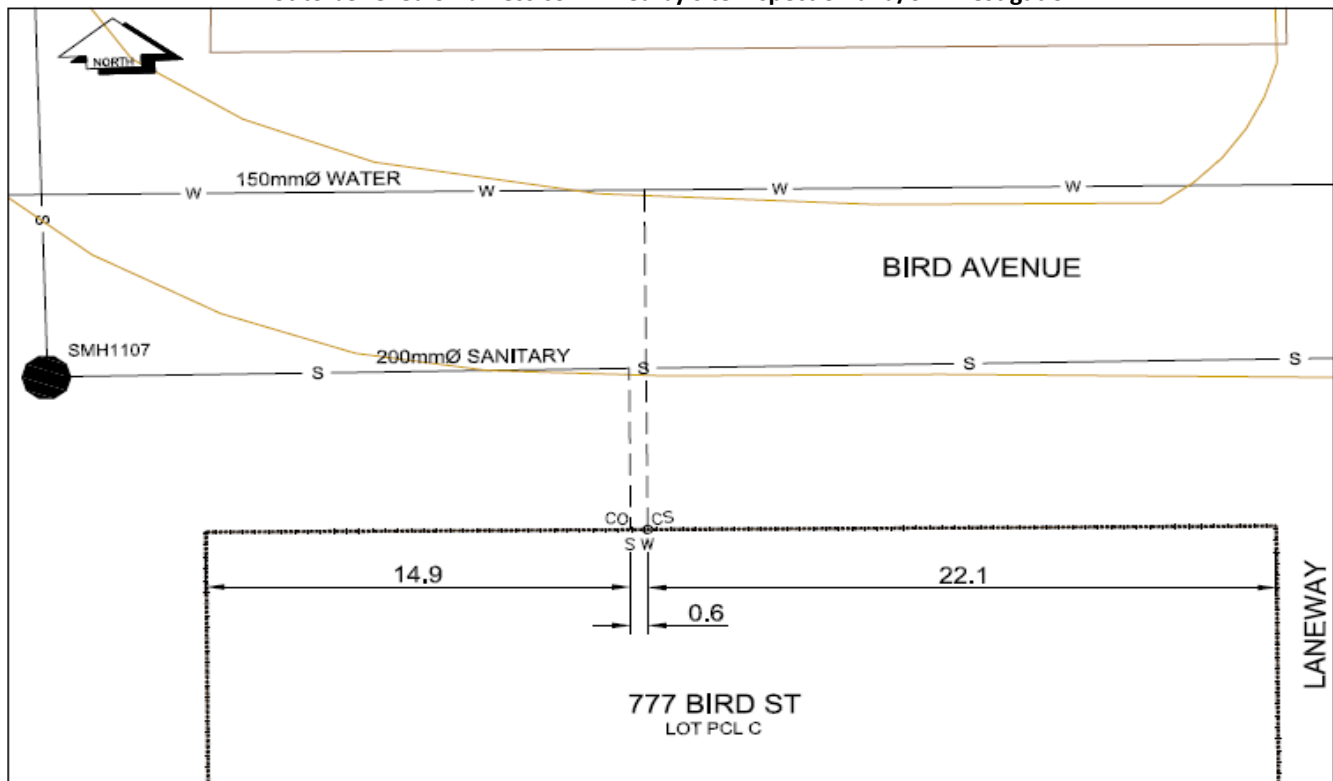

LEGEND:	CS ^o CURB STOP	— — — — — WATER SERVICE	— — — — — STORM SERVICE
	CO ^o CLEAN OUT	— — — — — SANITARY SERVICE	— G — GAS

NOT TO SCALE