



City of Prince George History Sheet

PID:	029049903
MU:	101355
WO:	70308/70309

Civic Address: 8555 Pacific St

Legal Description: Lot: A District Lot: 749 Plan: EPP26908


Service Type	Diameter (mm)	Material	Invert Elev at main (m)	Depth of cut at property line (m)	Invert Elev at service end (m)	Distance into property (m)	Installation Date
Sanitary	150mm	PVC	592.16	-	-	-	September 2013
Water	40mm	Copper	-	-	-	-	September 2013
Storm	N/A	N/A	-	-	-	-	

Service Connection Location	Sanitary (m)	Storm (m)
Sanitary service is connected to SMH4671	-	
Distance from downstream Stm MH - towards upstream Stm MH -		

Power	Size	Communications	Size	Cable	Size	Gas	Size
BC Hydro	-	Telus	-	Shaw	-	FortisBC	-
Overhead Service		Overhead Service		Overhead Service			

Installed by: City Forces	Survey Date: -
Comments:	

NOT TO SCALE The information contained herein is for internal use only.
Not to be relied on unless confirmed by site inspection and/or investigation.

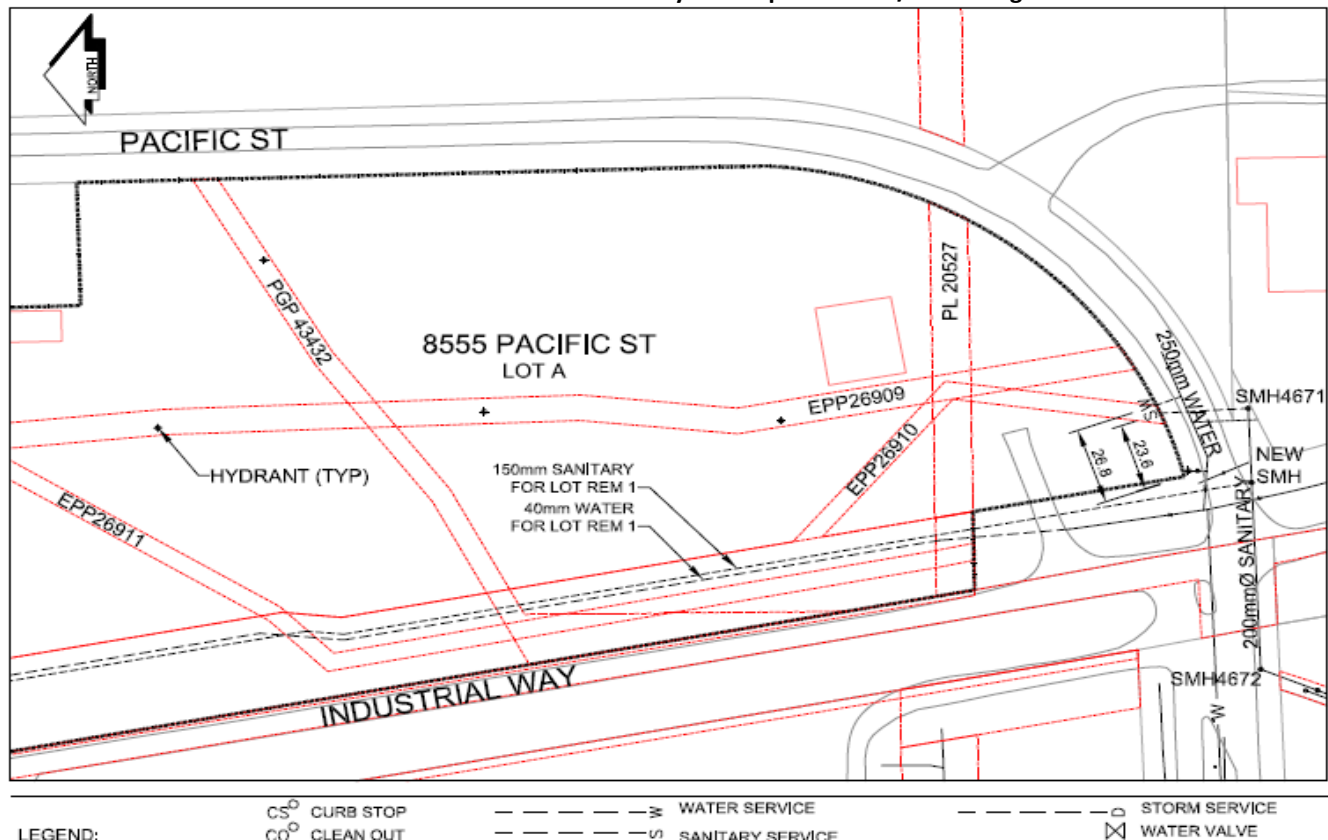

NOT TO SCALE