



# City of Prince George History Sheet

PID:	029055750
MU:	101404
WO:	72003/72004 72008

Civic Address: 499 George St

Legal Description: Lot: PCL D Block: 150 (CA3075105) District Lot: 343 Plan: 1268


Service Type	Diameter (mm)	Material	Invert Elev at MH (m)	Invert Elev at property line (m)	Invert Elev at service end (m)	Distance into property (m)	Installation Date
Sanitary	150mm	PVC	568.11	568.16	568.16	-	September 2013
Water	150mm	PVC	-	-	-	-	September 2013
Storm	200mm	PVC	568.40	568.45	568.45	-	September 2013

Service Connection Location	Sanitary (m)	Storm (m)
Sanitary service is connected to SMH4816	-	
Storm service is connected to DMH3042		

Power	Size	Communications	Size	Cable	Size	Gas	Size
BC Hydro	-	Telus	-	Shaw	-	FortisBC	-
Underground Service		Underground Service		Underground Service			

Installed by:	City of Prince George forces	Survey Date:	-
Comments:			

**NOT TO SCALE** The information contained herein is for internal use only.  
Not to be relied on unless confirmed by site inspection and/or investigation.

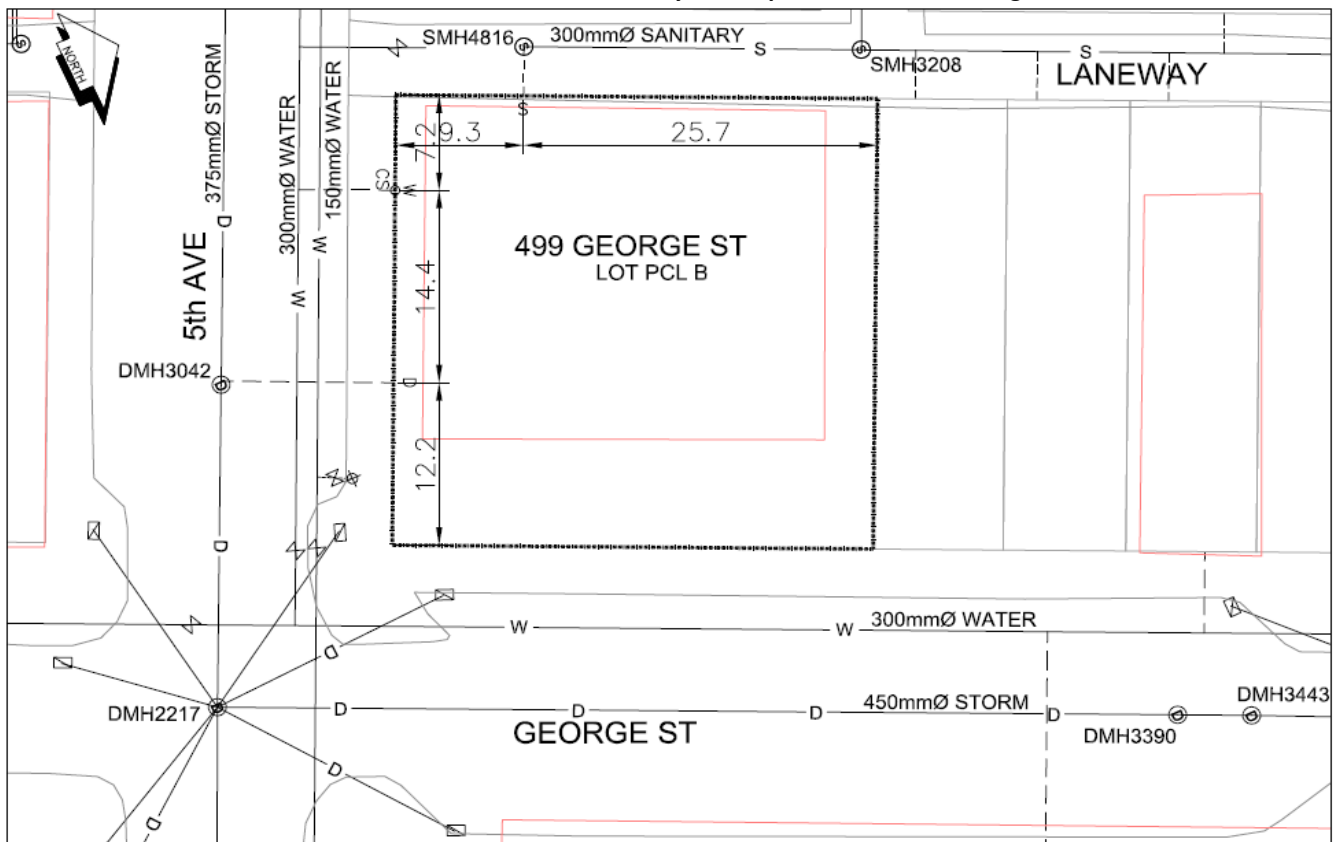

LEGEND:	CS CURB STOP	--- W WATER SERVICE	--- S SANITARY SERVICE	--- D STORM SERVICE	⊗ WATER VALVE
	CO CLEAN OUT				

**NOT TO SCALE**