



City of Prince George History Sheet

PID:	029066549
SD/MU:	
WO:	

Civic Address: 2844 Recplace Dr

Legal Description: Lot: A EXC PART IN PL EPP28683 District Lot: 8180 Plan: EPP18684


Service Type	Diameter (mm)	Material	Invert Elev at main (m)	Invert Elev at property line (m)	Invert Elev at service end (m)	Distance into property (m)	Installation Date
Sanitary	150mm	PVC	-	-	-	-	March 2013
Water	200mm	PVC	-	-	-	-	March 2013
Storm	N/A	N/A	-	-	-	-	

Service Connection Location	Sanitary (m)	Storm (m)
150mm Sanitary service connected to San MH	-	
Distance from downstream Stm MH - towards upstream Stm MH -		

Power	Size	Communications	Size	Cable	Size	Gas	Size
BC Hydro	-	Telus	-	Shaw	-	FortisBC	-
Underground Service		Underground Service		Underground Service			

Installed by:	Survey Date:	-
Comments: Storm drainage handle by onsite recharge chambers		

NOT TO SCALE The information contained herein is for internal use only.
Not to be relied on unless confirmed by site inspection and/or investigation.

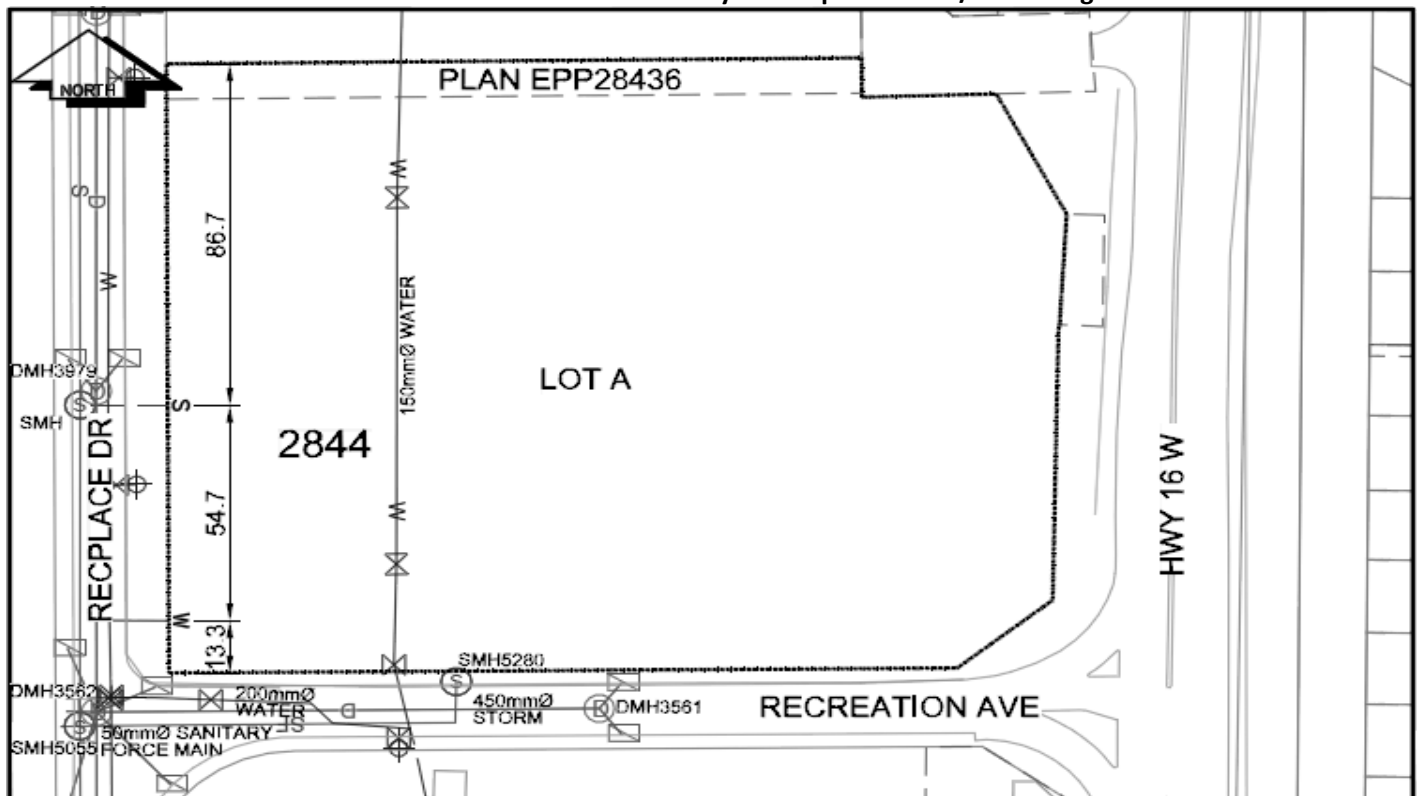

CS CURB STOP	--- WATER SERVICE	--- STORM SERVICE
CO CLEAN OUT	--- SANITARY SERVICE	--- GAS
WATER VALVE	--- FIRE HYDRANT	--- ENCUMBRANCE

NOT TO SCALE