



City of Prince George
History Sheet

PID:	029066948
MU:	101362
WO:	70542

Civic Address: 2114 2116 Redwood St

Legal Description: Lot: A District Lot: 777 Plan: EPP22325


Service Type	Diameter (mm)	Material	Invert Elev at main (m)	Invert Elev at property line (m)	Invert Elev at service end (m)	Distance into property (m)	Installation Date
Sanitary	100mm	PVC	-	-	-	-	May 2013
Sanitary	100mm	PVC	-	-	-	-	January 1965
Water	20mm	Copper	-	-	-	-	May 2013
Water	20mm	Copper	-	-	-	-	May 2013
Storm	N/A	N/A	-	-	-	-	

Service Connection Location				Sanitary (m)	Storm (m)
Distance from downstream San MH	3365	towards upstream San MH	3382	43.20	
Distance from downstream San MH	3365	towards upstream San MH	3382	34.70	

Power	Size	Communications	Size	Cable	Size	Gas	Size
BC Hydro	-	Telus	-	Shaw	-	FortisBC	-
Overhead Service		Overhead Service		Overhead Service			

Installed by:	City of Prince George forces	Survey Date:	-
Comments:			

NOT TO SCALE The information contained herein is for internal use only.
Not to be relied on unless confirmed by site inspection and/or investigation.

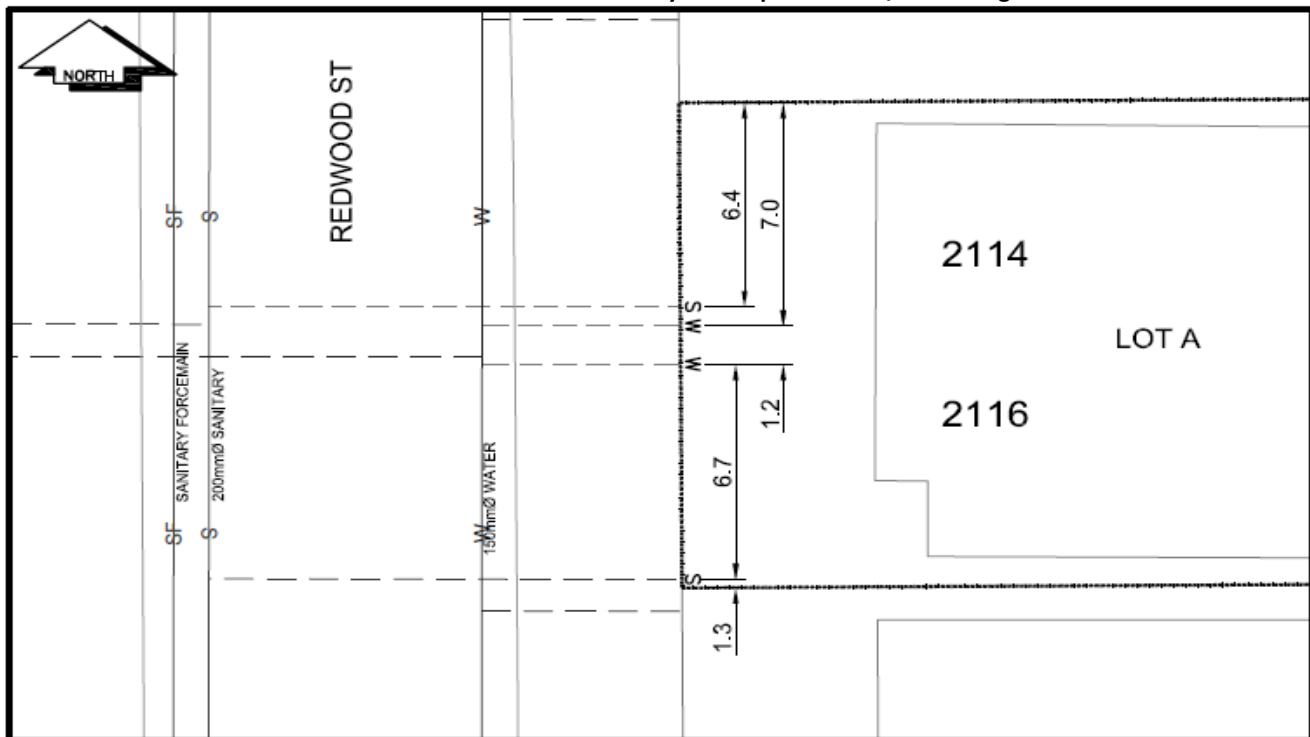

CS ^o	CURB STOP	---	W	WATER SERVICE	---	o	STORM SERVICE
CO ^o	CLEAN OUT	---	S	SANITARY SERVICE	---	G	GAS

NOT TO SCALE