



City of Prince George  
**History Sheet**

PID:	029077826
SD:	SD100363
WO:	

Civic Address: 2888 Andres Rd

Legal Description: Lot: 2 District Lot: 1433 Plan: EPP23883


Service Type	Diameter (mm)	Material	Invert Elev at main (m)	Depth of cut at property line (m)	Invert Elev at service end (m)	Distance into property (m)	Installation Date
Sanitary	100mm	PVC	-	2.42	-	-	October 1980
Water	20mm	Copper	-	-	-	-	October 1980
Storm	N/A	N/A	-	-	-	-	

Service Connection Location				Sanitary (m)	Storm (m)
Distance from downstream San MH	-	towards upstream San MH	-	-	
Distance from downstream Stm MH	-	towards upstream Stm MH	-		

Power	Size	Communications	Size	Cable	Size	Gas	Size
BC Hydro	-	Telus	-	Shaw	-	FortisBC	-
Overhead Service		Overhead Service		Overhead Service			

Installed by:	City of Prince George forces	Survey Date:	-
Comments:			

**NOT TO SCALE** The information contained herein is for internal use only.  
Not to be relied on unless confirmed by site inspection and/or investigation.

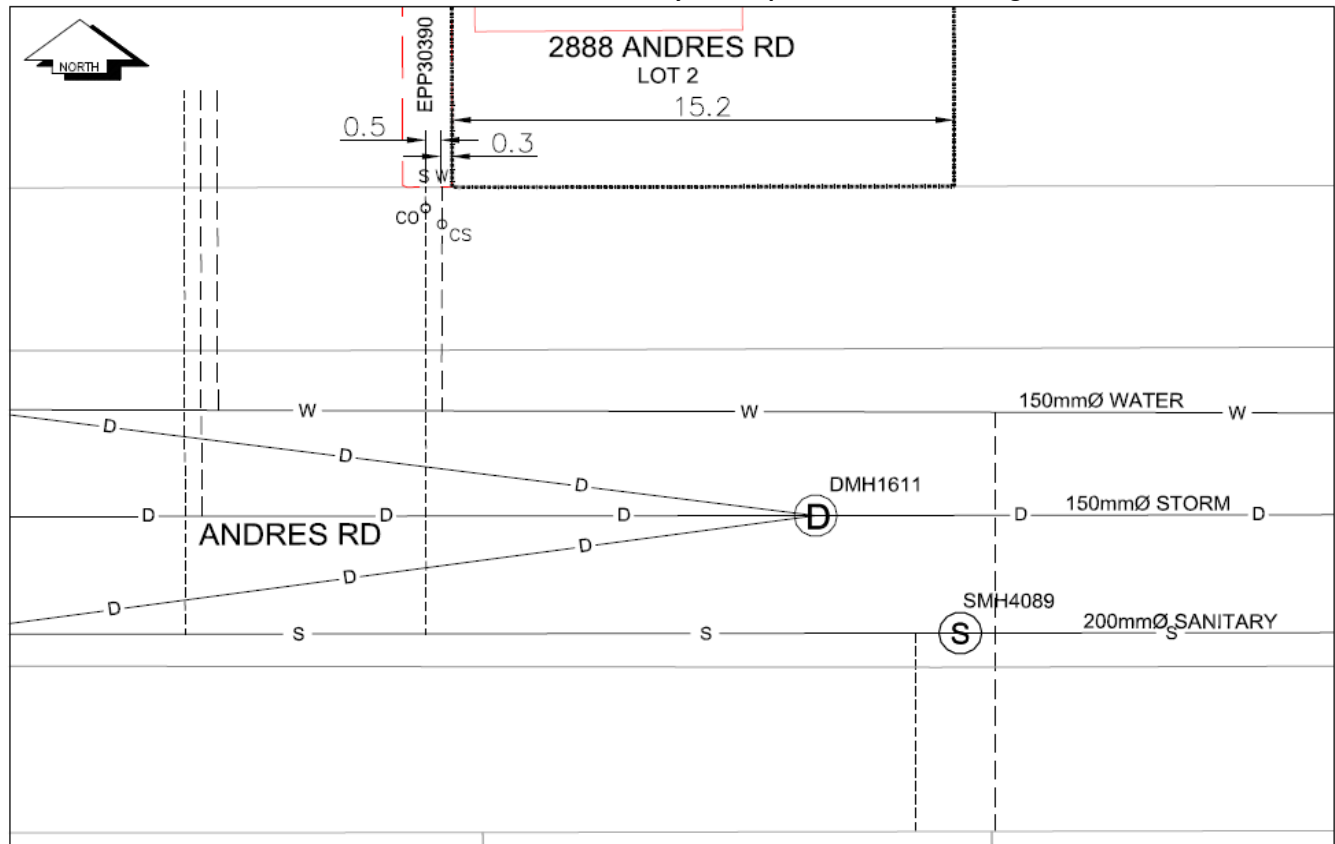

LEGEND:	CS <sup>o</sup> CURB STOP	--- WATER SERVICE	--- STORM SERVICE
	CO <sup>o</sup> CLEAN OUT	--- SANITARY SERVICE	⊗ WATER VALVE

**NOT TO SCALE**