



City of Prince George
History Sheet

PID:	029147557
SD/MU:	101393
WO:	72244/ 72245

Civic Address: 7367 Carr Rd

Legal Description: Lot: 7 District Lot: 2433 Plan: EPP25213


Service Type	Diameter (mm)	Material	Invert Elev at main (m)	Invert Elev at property line (m)	Invert Elev at service end (m)	Distance into property (m)	Installation Date
Sanitary	100mm	PVC	-	-	-	-	September 2013
Water	20mm	Copper	-	-	-	-	September 2013
Storm	N/A	N/A	-	-	-	-	

Service Connection Location				Sanitary (m)	Storm (m)
Distance from downstream San MH	232	towards upstream San MH	206	66.20	
Distance from downstream Stm MH	-	towards upstream Stm MH	-		

Power	Size	Communications	Size	Cable	Size	Gas	Size
BC Hydro	-	Telus	-	Shaw	-	FortisBC	-
Overhead Service		Overhead Service		Overhead Service			

Installed by:	City of Prince George forces	Survey Date:	-
Comments:			

NOT TO SCALE The information contained herein is for internal use only.
Not to be relied on unless confirmed by site inspection and/or investigation.

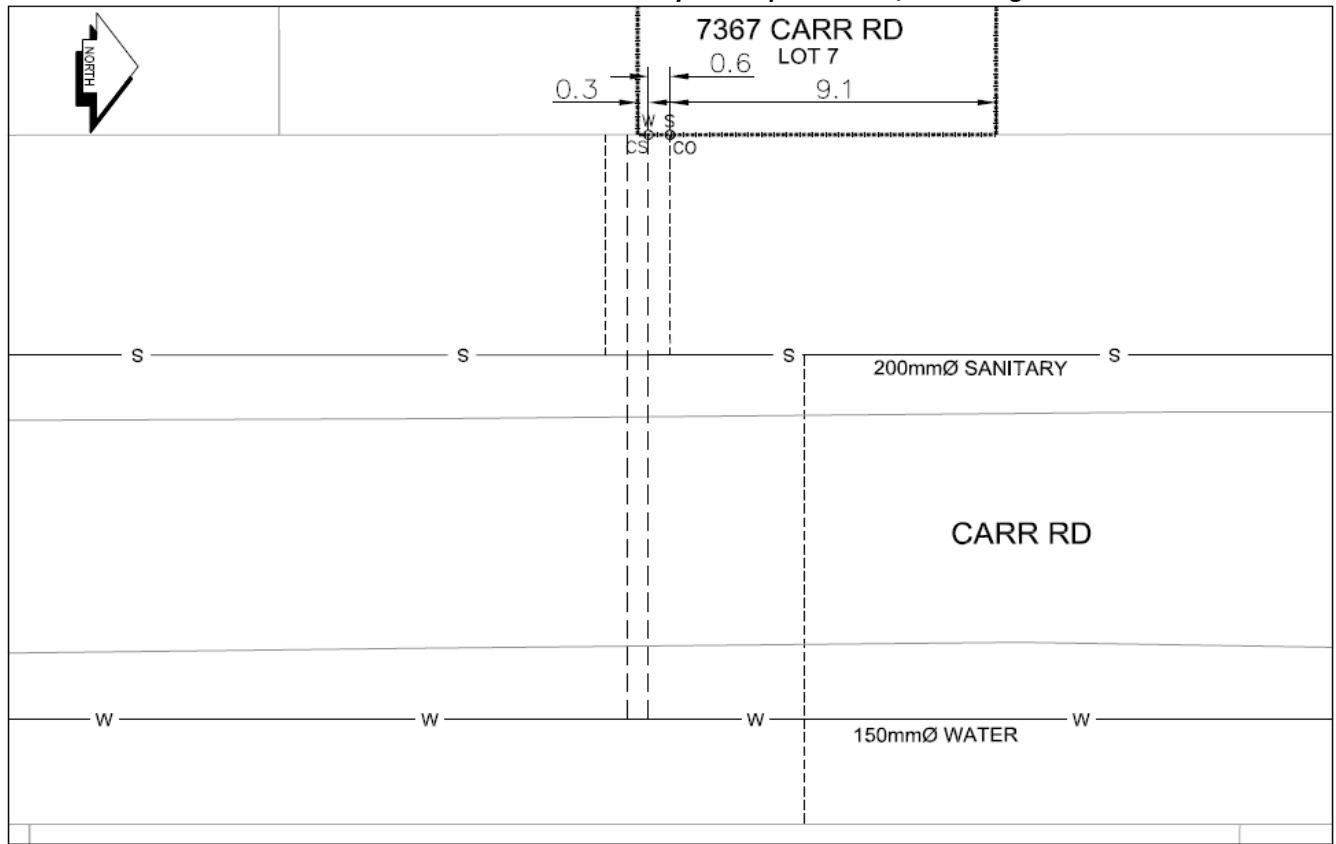

LEGEND:	CS ^o CURB STOP	— — — — — WATER SERVICE	— — — — — STORM SERVICE
	CO ^o CLEAN OUT	— — — — — SANITARY SERVICE	⊗ WATER VALVE

NOT TO SCALE