



City of Prince George
History Sheet

| | |
|--------|-----------|
| PID: | 029148260 |
| SD/MU: | |
| WO: | |

Civic Address: 2255 Quince St

Legal Description: Lot: PCL A (CA3305101) District Lot: 932 Plan: 796


| Service Type | Diameter (mm) | Material | Invert Elev at main (m) | Depth of Cut at property line (m) | Invert Elev at service end (m) | Distance into property (m) | Installation Date |
|--------------|---------------|----------|-------------------------|-----------------------------------|--------------------------------|----------------------------|-------------------|
| Sanitary | 100mm | AC | - | 3.99 | 566.47 | 3.00 | Jan 1975 |
| Water | 20mm | Copper | - | - | - | - | |
| Storm | N/A | N/A | - | - | - | - | |

| Service Connection Location | | | | Sanitary (m) | Storm (m) |
|---------------------------------|------|-------------------------|------|--------------|-----------|
| Distance from downstream San MH | 2967 | towards upstream San MH | 3463 | 67.20 | |
| Distance from downstream Stm MH | - | towards upstream Stm MH | - | | |

| Power | Size | Communications | Size | Cable | Size | Gas | Size |
|------------------|------|------------------|------|------------------|------|----------|------|
| BC Hydro | - | Telus | - | Shaw | - | FortisBC | - |
| Overhead Service | | Overhead Service | | Overhead Service | | | |

| | | |
|---------------|--------------|---|
| Installed by: | Survey Date: | - |
| Comments: | | |

NOT TO SCALE The information contained herein is for internal use only.
Not to be relied on unless confirmed by site inspection and/or investigation.

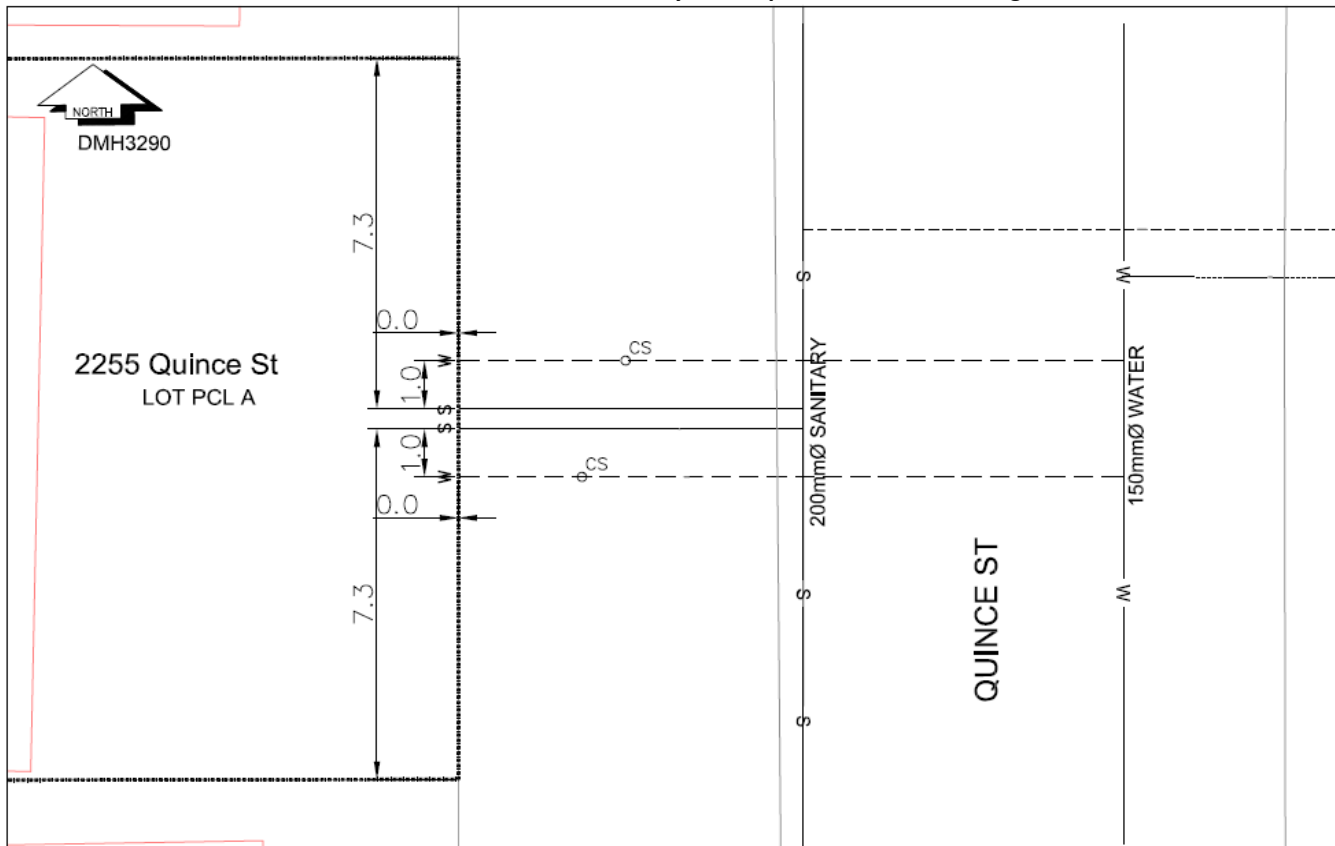

| | | | |
|---------|---------------------------|--------------------------|-----------------------|
| LEGEND: | CS ^o CURB STOP | ---W--- WATER SERVICE | ---D--- STORM SERVICE |
| | CO ^o CLEAN OUT | ---S--- SANITARY SERVICE | WV WATER VALVE |

NOT TO SCALE