

City of Prince George

HISTORY SHEET

PID: 029178258

Scale: 1:500

Legal: LOT 1

D.L.: 1433

PLAN: EPP32539

Address: 3990 BARNES DR

Sanitary Connection:# SIZE: 100mmØ MATERIAL: PVC INV. AT R 638.76m CONNECTED

Water Connection:# SIZE: 19mmØ MATERIAL: Copper INV. AT R 638.85m

Storm Connection:# SIZE: 100mmØ MATERIAL: PVC INV. AT R 638.75m CONNECTED

Cash Receipt No's: WATER SANITARY STORM

CURB FROM PROPERTY LINE 5m PAVEMENT WIDTH 10m

HYDRO 75mm DB2 U/G CONNECTION


TELEPHONE 100mm DB2 U/G CONNECTION

GAS 42 PROP/P.E.

Information Sheets: REF. DWGS. L&M ENGINEERING LTD. JOB. 1432-01-04 DWGS.

Comments: CS CURB STOP CO CLEAN OUT WDS WATER SERVICE SOW STORM SERVICE SANITARY SERVICE HYDRO SERVICE CABLE SERVICE TELECOMMUNICATIONS GAS ELECTRICAL

THE INFORMATION CONTAINED HEREIN IS FOR INTERNAL USE ONLY.
NOT TO BE RELIED UPON UNLESS CONFIRMED BY THE SITE INSPECTION AND/OR INVESTIGATION

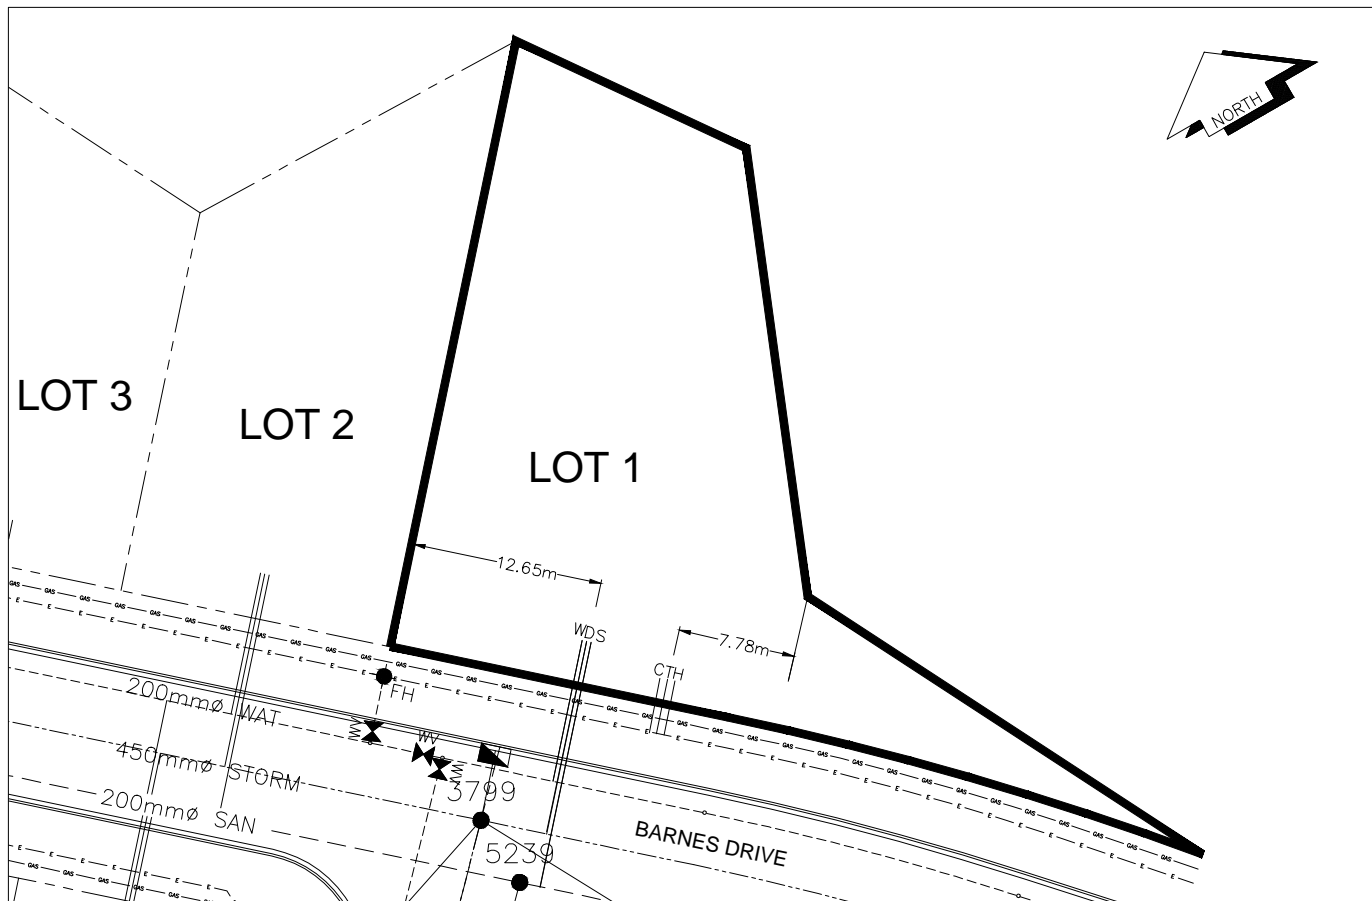

DATE INSTALLED: JUNE 2013

INSTALLED BY: SUNLAND UTILITIES LTD

DATE INSTALLED: JUNE 2013

INSTALLED BY: SUNLAND UTILITIES LTD.

DATE INSTALLED: JUNE 2013

INSTALLED BY: SUNLAND UTILITIES LTD.