

City of Prince George

HISTORY SHEET

PID: **029178291**

Scale: 1:500

Legal: LOT 5

D.L.: 1433

PLAN: EPP32539

Address: **3966 BARNES DR**

Sanitary Connection:# SIZE: 100mmØ MATERIAL: PVC INV. AT \mathbb{R} 641.98m CONNECTED

Water Connection:# SIZE: 19mmØ MATERIAL: Copper INV. AT \mathbb{R} 642.03m

Storm Connection:# SIZE: 100mmØ MATERIAL: PVC INV. AT \mathbb{R} 642.02m CONNECTED

Cash Receipt No's: WATER SANITARY STORM

CURB FROM PROPERTY LINE 5m PAVEMENT WIDTH 10m

HYDRO 75mm DB2 U/G CONNECTION ✓


TELEPHONE 100mm DB2 U/G CONNECTION ✓

GAS 42 PROP/P.E.

Information Sheets: REF. DWGS. L&M ENGINEERING LTD. JOB. 1432-01-04 DWGS.

Comments: CS CURB STOP CO CLEAN OUT SOW WATER SERVICE SOW STORM SERVICE SOW SANITARY SERVICE HYDRO SERVICE CABLE SERVICE TELECOMMUNICATIONS GAS ELECTRICAL

THE INFORMATION CONTAINED HEREIN IS FOR INTERNAL USE ONLY.
NOT TO BE RELIED UPON UNLESS CONFIRMED BY THE SITE INSPECTION AND/OR INVESTIGATION

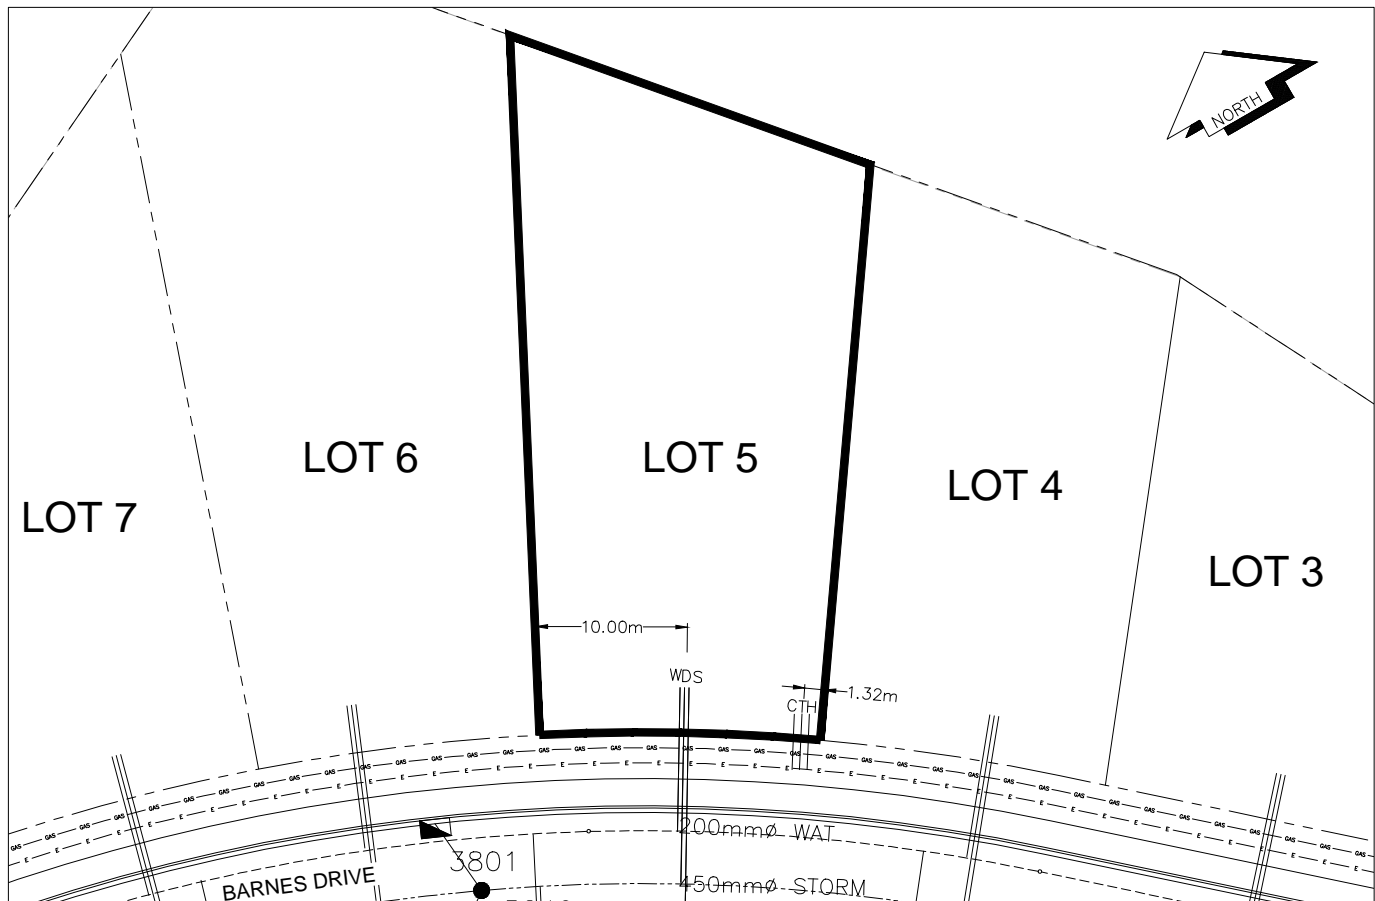

SANITARY, STORM & WATER SERVICE INVERTS	SANITARY	WATER	STORM
1. Distance from San. M.H. <u>5239</u> toward San. M.H. <u>5240</u> to lot service connection point is:	75.82m	N/A	N/A
1a.Distance from Stm. M.H. <u>3799</u> toward Stm. M.H. <u>3801</u> to lot service connection point is:	N/A	N/A	72.37m
2. Main Size at connection point is	200mmØ	200mmØ	450mmØ
3. Invert of service at main conn. stub point is	641.58m	641.24m	641.15m
4. Invert at service end is	642.09m	642.07m	642.08m
5. Cover at property line in meters	2.83m	2.86m	2.79m
6. Survey Date: JUNE 2013 Book Ref.: 1432-01-04 By: L&M ENGINEERING LTD			

SANITARY HISTORY:

DATE INSTALLED: JUNE 2013

INSTALLED BY: SUNLAND UTILITIES LTD

WATER HISTORY:

DATE INSTALLED: JUNE 2013

INSTALLED BY: SUNLAND UTILITIES LTD.

STORM HISTORY:

DATE INSTALLED: JUNE 2013

INSTALLED BY: SUNLAND UTILITIES LTD.