
City of Prince George HISTORY SHEET

PID:	029178410					5	Scale:	1:500			
l ogal:	LOT 17					Г) I ·	1433		DI ANI:	EPP32539
Legal:	LOT I7					L	J.L	1433		FLAIN.	EFF32339
Address	s: 3936 ESTAB	ROOK CF	RT								
Sanitary	/ Connection:#		SIZE:	100mmØ	MATERIAL:	PVC		INV. AT PL	645.32m	CONN	ECTED
Water C	Connection:#		SIZE:	19mmØ	MATERIAL:	Copper		INV. AT P	645.05m		
Storm C	Connection:#		SIZE	100mmØ	MATERIAL	PVC		INV. AT PL	645.32m	CONNE	ECTED
Cash R	eceipt No's:			WATER		SANITARY	,		S	TORM	
CURB F	FROM PROPER	TY LINE	5m					P	AVEMENT V	/IDTH	10m
HYDRO)	75mm D	B2			U/G CONNE	СТІО	N ~	/		
TELEPH	HONE	100mm l	DB2			U/G CONNE	СТІО	N ~	/		
GAS		42 PRO	P/P.E.								
Informa	ormation Sheets: REF. DWGS. L&M ENGINEERING LTD. JOB. 1432-01-04 DWGS.										
Comme	ents:	CS CO	CURB STOP CLEAN OUT		WATER SERVICE STORM SERVICE SANITARY SERV	ICE	===	HYDRO SER CABLE SER TELECOMM	RVICE VICE UNICASTION:	S - t - t -	- GAS - ELECTRICAL

THE INFORMATION CONTAINED HEREIN IS FOR INTERNAL USE ONLY.

NOT TO BE RELIED UPON UNLESS CONFIRMED BY THE SITE INSPECTION AND/OR INVESTIGATION

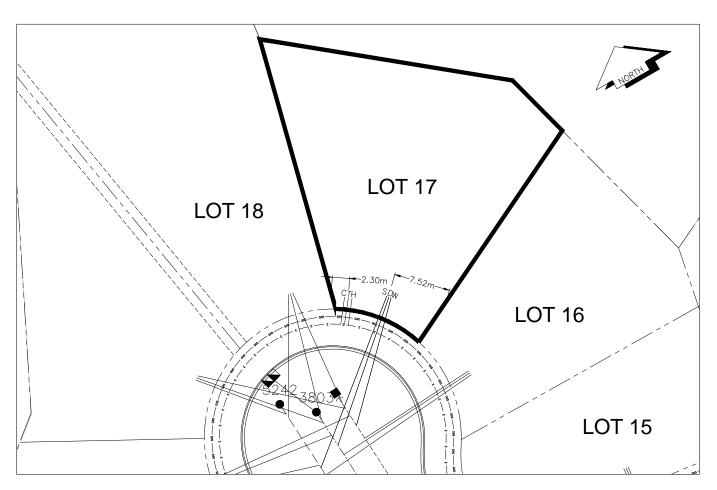

SANITARY, STORM & WATER SERVICE INVERTS	SANITARY	WATER	STORM
1. Distance from San. M.H. <u>5241</u> toward San. M.H. <u>5242</u> to lot service connection point is:	34.99m	N/A	N/A
1a.Distance from Stm. M.H. 3802 toward Stm. M.H. 3803 to lot service connection point is:	N/A	N/A	35.02m
2. Main Size at connection point is	200mmØ	200mmØ	300mmØ
3. Invert of service at main conn. stub point is	644.68m	644.56m	644.72m
4. Invert at service end is	645.35m	645.04m	645.36m
5. Cover at property line in meters	2.36m	2.71m	2.36m
6. Survey Date: JUNE 2013 Book Ref.: 1432-01-04 By: L&M ENGINEERING LTD			
SANITARY HISTORY:			
DATE INSTALLED: JUNE 2013			
INSTALLED BY: SUNLAND UTILITIES LTD			
INSTALLED BY. SUNLAND UTILITIES LTD			
WATER HISTORY:			
DATE INSTALLED: JUNE 2013			
INSTALLED BY: SUNLAND UTILITIES LTD.			
STORM HISTORY:			
DATE INSTALLED: JUNE 2013			
INSTALLED BY: SUNLAND UTILITIES LTD.			