



City of Prince George
History Sheet

PID:	029198518
MU:	101389/101479
WO:	71974/71975

Civic Address: 4677 Martin Rd

Legal Description: Lot: 1 District Lot: 2424 Plan: EPP32679


Service Type	Diameter (mm)	Material	Invert Elev at main (m)	Depth of cut at property line (m)	Invert Elev at service end (m)	Distance into property (m)	Installation Date
Sanitary	100mm	PVC	-	-	-	-	September 2013
Water	20mm	Copper	-	-	-	-	September 2013
Storm	N/A	N/A	-	-	-	-	

Service Connection Location				Sanitary (m)	Storm (m)
Distance from downstream San MH	167	towards upstream San MH	163	49.80	
Distance from downstream Stm MH	-	towards upstream Stm MH	-		

Power	Size	Communications	Size	Cable	Size	Gas	Size
BC Hydro	-	Telus	-	Shaw	-	FortisBC	-
Overhead Service		Overhead Service		Overhead Service			

Installed by:	City of Prince George forces	Survey Date:	-
Comments:			

NOT TO SCALE The information contained herein is for internal use only.
Not to be relied on unless confirmed by site inspection and/or investigation.

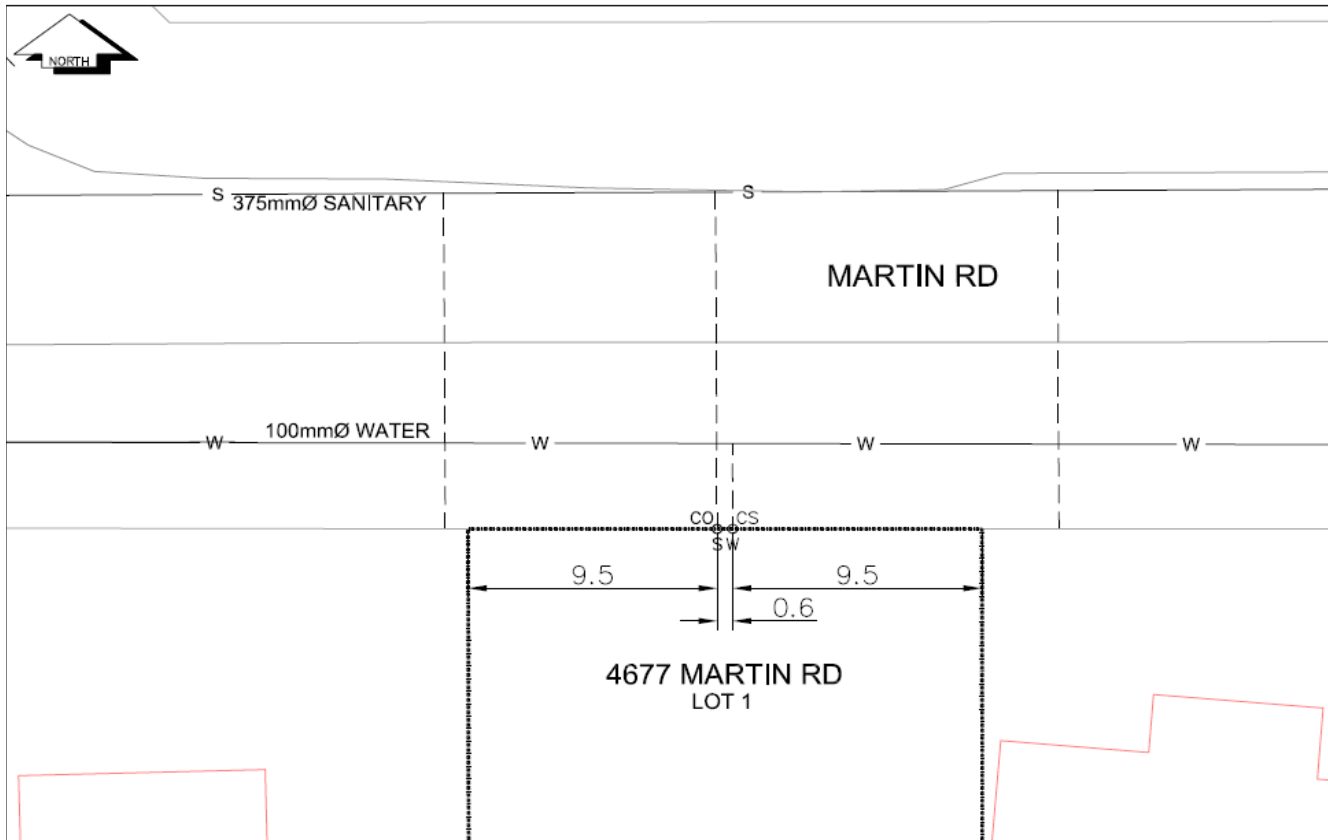

LEGEND:	CS ^o CURB STOP	--- W WATER SERVICE	--- S SANITARY SERVICE	--- SW STORM SERVICE	⊗ WATER VALVE
	CO ^o CLEAN OUT				

NOT TO SCALE