



# City of Prince George History Sheet

PID:	029199298
PID:	029199301
MU:	101315
WO:	70745/70747

Civic Address: 753 755 Douglas St

Legal Description: Lot: A, B District Lot: 937 Plan: EPP33200


Service Type	Diameter (mm)	Material	Invert Elev at main (m)	Invert Elev at property line (m)	Invert Elev at service end (m)	Distance into property (m)	Installation Date
Sanitary - Lot A	100mm	PVC	-	-	-	1.32	May 2013
Sanitary - Lot B	100mm	PVC	-	-	-	1.42	May 2014
Water - Lot A	20mm	Copper	-	-	-	0.92	May 2015
Water - Lot B	20mm	Copper	-	-	-	0.92	May 2016
Storm	N/A	N/A	-	-	-	-	

Service Connection Location				Sanitary (m)	Storm (m)
Distance from downstream San MH	1970	towards upstream San MH	2669	52.40	
Distance from downstream San MH	1970	towards upstream San MH	2669	51.80	

Power	Size	Communications	Size	Cable	Size	Gas	Size
BC Hydro	-	Telus	-	Shaw	-	FortisBC	-
Overhead Service		Overhead Service		Overhead Service			

Installed by:	City of Prince George forces	Survey Date:	-
Comments:	Services locations confirmed by John Handler - October 2016.		

**NOT TO SCALE** The information contained herein is for internal use only.  
Not to be relied on unless confirmed by site inspection and/or investigation.

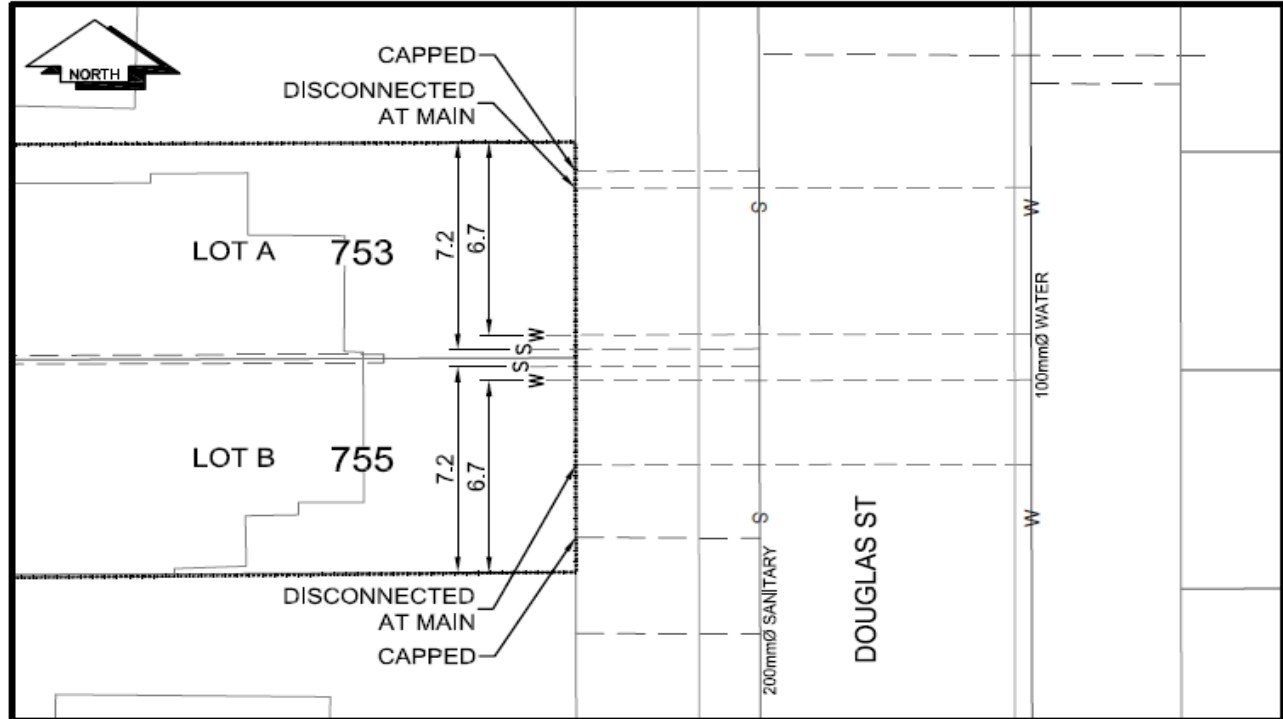

CS	CURB STOP	---	W	WATER SERVICE	---	D	STORM SERVICE
CO	CLEAN OUT	---	S	SANITARY SERVICE	---	G	GAS

**NOT TO SCALE**