



City of Prince George
History Sheet

PID:	029201616
MU:	101417
WO:	73467

Civic Address: 770 Central St E

Legal Description: Lot: A District Lot: 937 Plan: EPP33297


Service Type	Diameter (mm)	Material	Invert Elev at main (m)	Depth of Cut at property line (m)	Invert Elev at service end (m)	Distance into property (m)	Installation Date
Sanitary	100mm	AC	597.13	1.83	597.64	-	May 1975
Water	25mm	Copper	-	-	-	-	October 2013
Storm	N/A	N/A	-	-	-	-	

Service Connection Location				Sanitary (m)	Storm (m)
Distance from downstream San MH	1948	towards upstream San MH	2653	103.50	
Distance from downstream Stm MH	-	towards upstream Stm MH	-		

Power	Size	Communications	Size	Cable	Size	Gas	Size
BC Hydro	-	Telus	-	Shaw	-	FortisBC	-
Overhead Service		Overhead Service		Overhead Service			

Installed by:	City of Prince George forces	Survey Date:	-
Comments:			

NOT TO SCALE The information contained herein is for internal use only.
Not to be relied on unless confirmed by site inspection and/or investigation.

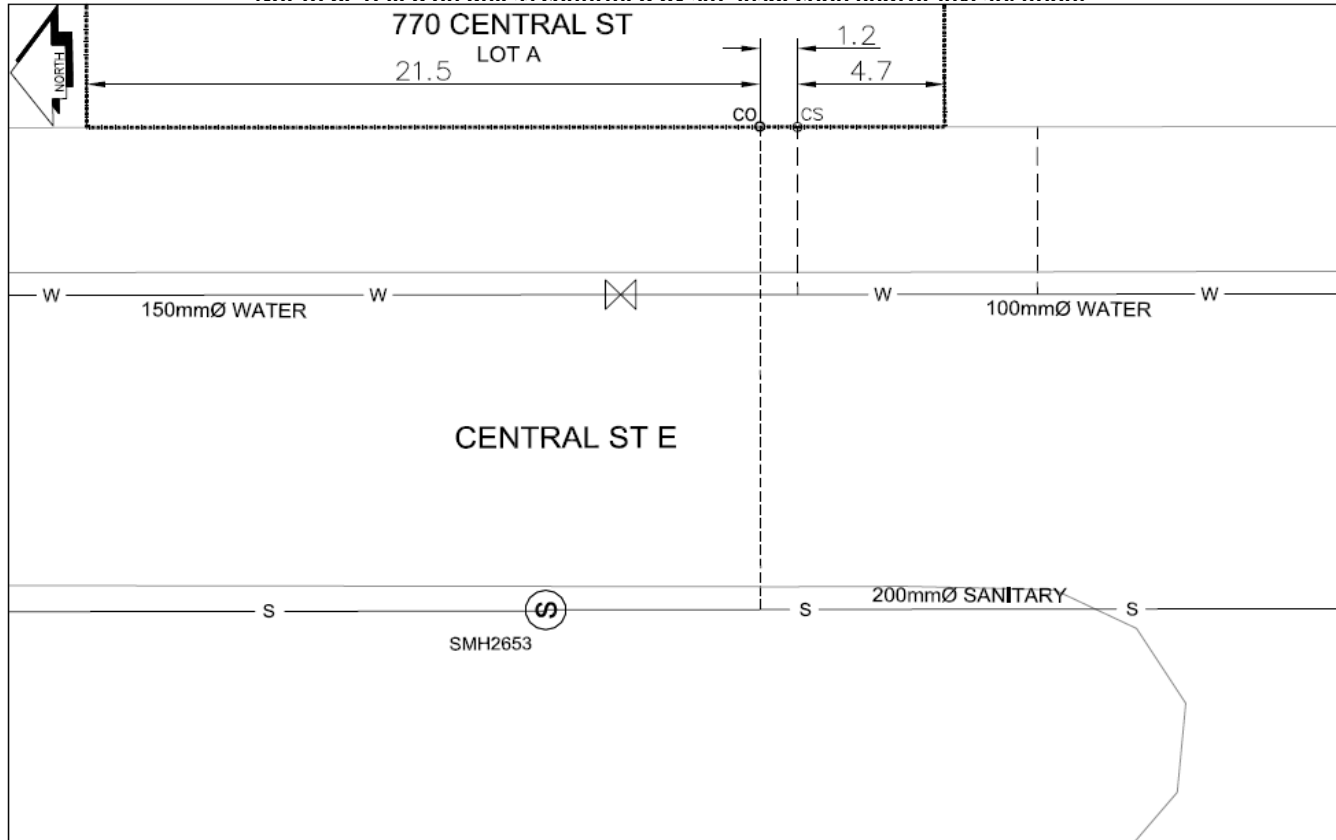

LEGEND:	CS CURB STOP	--- WATER SERVICE	--- STORM SERVICE
	CO CLEAN OUT	--- SANITARY SERVICE	⊗ WATER VALVE

NOT TO SCALE