



City of Prince George History Sheet

PID:	029201667
SD/MU:	
WO:	

Civic Address: 780 Central St E

Legal Description: Lot: B District Lot: 937 Plan: EPP33297


Service Type	Diameter (mm)	Material	Invert Elev at main (m)	Invert Elev at property line (m)	Invert Elev at service end (m)	Distance into property (m)	Installation Date
Sanitary	100mm	AC	-	-	-	-	January 1961
Sanitary	100mm	AC	-	-	-	-	January 1961
Sanitary	100mm	AC	-	-	-	-	January 1961
Water	20mm	Copper	-	-	-	-	January 1960
Water	20mm	Copper	-	-	-	-	January 1960
Water	20mm	Copper	-	-	-	-	January 1960
Storm	N/A	N/A	-	-	-	-	

Service Connection Location				Sanitary (m)	Storm (m)
Distance from downstream San MH	1948	towards upstream San MH	2653	77.64	
Distance from downstream San MH	1948	towards upstream San MH	2653	70.97	
Distance from downstream San MH	1948	towards upstream San MH	2653	51.64	
Distance from downstream Stm MH	-	towards upstream Stm MH	-		

Power	Size	Communications	Size	Cable	Size	Gas	Size
BC Hydro	-	Telus	-	Shaw	-	FortisBC	-
Overhead Service		Overhead Service		Overhead Service			

Installed by:	Survey Date:	-
Comments:	Water and Sanitary service sizes and materials assumed	

NOT TO SCALE The information contained herein is for internal use only.
Not to be relied on unless confirmed by site inspection and/or investigation.

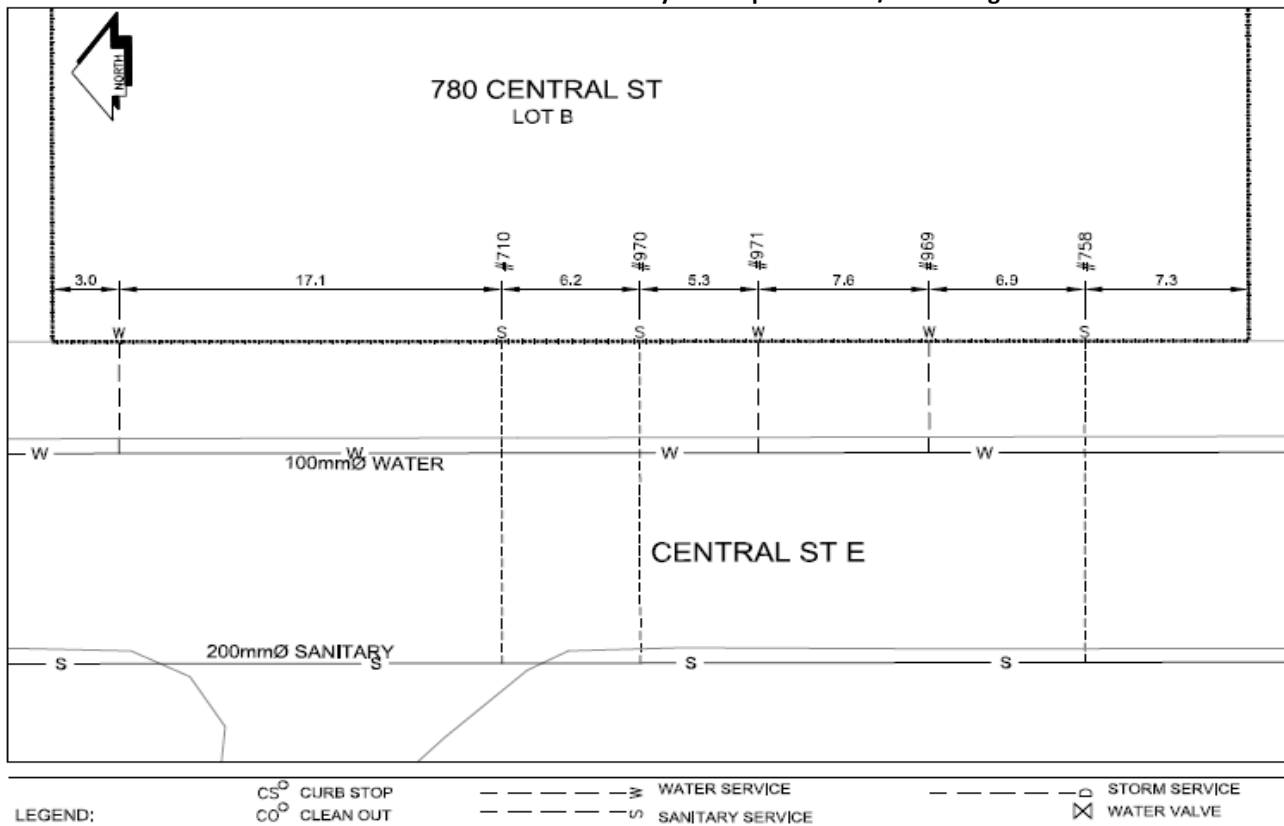

NOT TO SCALE