



City of Prince George History Sheet

PID:	029215005
MU:	100152
WO:	02-P011

Civic Address: 2601 Recplace Dr

Legal Description: Lot: B & DL 8180 District Lot: 8173 and 8180 Plan: EPP31314 except EPP78234


Service Type	Diameter (mm)	Material	Invert Elev at main (m)	Invert Elev at property line (m)	Invert Elev at service end (m)	Distance into property (m)	Installation Date
Sanitary - S1	100mm	PVC	-	-	-	-	December 1982
Sanitary - S2	100mm	PVC	-	-	-	-	December 1982
Sanitary - S3	100mm	PVC	-	-	-	-	December 1982
Water	200mm	PVC	-	-	-	-	April 2015
Storm	N/A	N/A	-	-	-	-	

Service Connection Location	Sanitary (m)	Storm (m)
100mm Sanitary service (S1) connected tp San MH 5272	-	
100mm Sanitary service (S2 & S3) connected tp San MH 5273		

Power	Size	Communications	Size	Cable	Size	Gas	Size
BC Hydro	-	Telus	-	Shaw	-	FortisBC	-
Overhead Service		Overhead Service		Overhead Service			

Installed by:	Survey Date:	-
Comments: Storm drainage handled by onsite recharge chamber		

NOT TO SCALE The information contained herein is for internal use only.
Not to be relied on unless confirmed by site inspection and/or investigation.

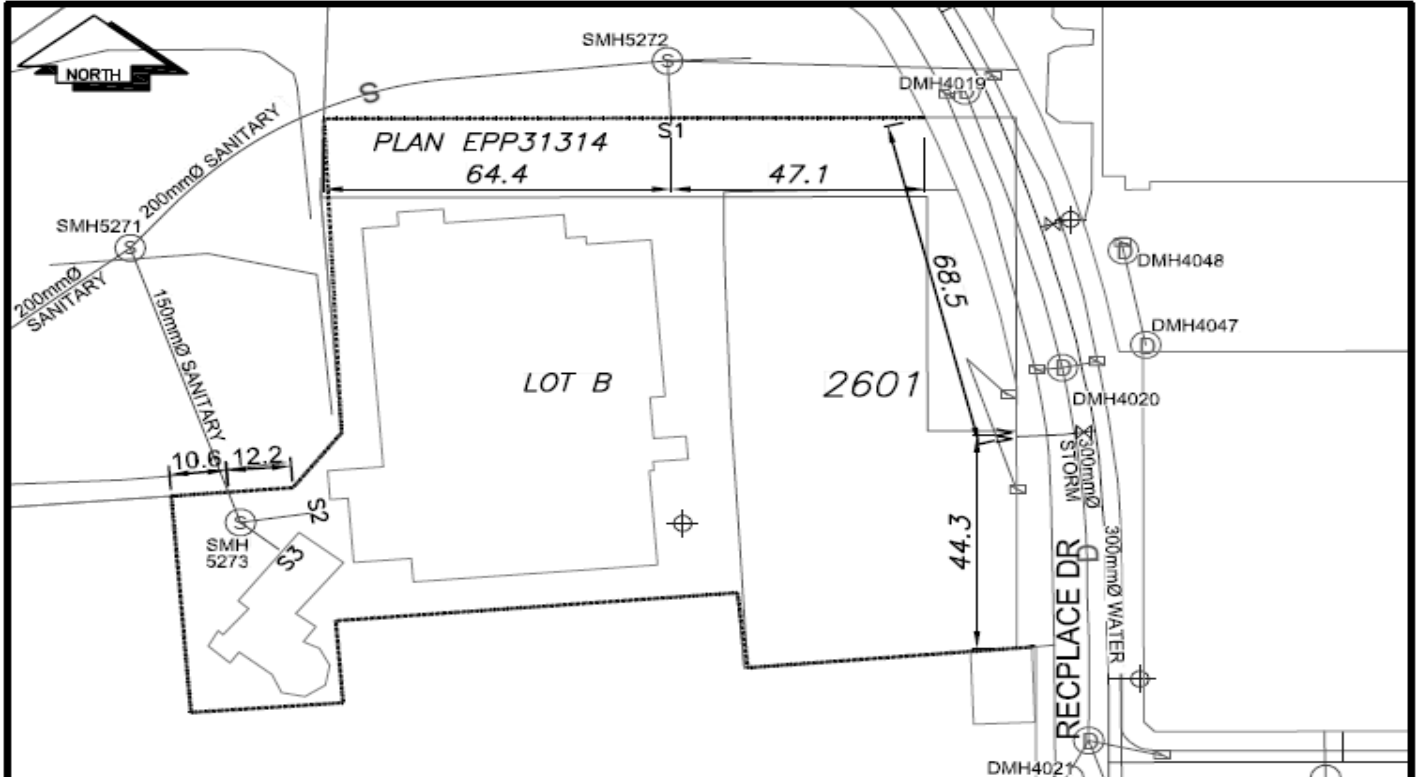

CS ^o CURB STOP	— WATER SERVICE	— STORM SERVICE
CO ^o CLEAN OUT	- - - - - SANITARY SERVICE	— G — GAS
⊗ WATER VALVE	⊗ FIRE HYDRANT	- - - - - ENCUMBRANCE

NOT TO SCALE