

City of Prince George

HISTORY SHEET

PID: 029-233-879

Scale: 1:500

Legal: LOT 9

D.L.: 1433

PLAN: EPP34474

Address: 3933 ESTABROOK CRT

| | | | | |
|-----------------------|--------------|---------------|-------------------|-----------|
| Sanitary Connection:# | SIZE: 100mmØ | MATERIAL: PVC | INV. AT R 645.25m | CONNECTED |
|-----------------------|--------------|---------------|-------------------|-----------|

| | | | | |
|--------------------|-------------|------------------|-------------------|--|
| Water Connection:# | SIZE: 19mmØ | MATERIAL: Copper | INV. AT R 644.77m | |
|--------------------|-------------|------------------|-------------------|--|

| | | | | |
|--------------------|--------------|---------------|-------------------|-----------|
| Storm Connection:# | SIZE: 100mmØ | MATERIAL: PVC | INV. AT R 645.27m | CONNECTED |
|--------------------|--------------|---------------|-------------------|-----------|

| | | | |
|--------------------|-------|----------|-------|
| Cash Receipt No's: | WATER | SANITARY | STORM |
|--------------------|-------|----------|-------|

| | | | |
|-------------------------|----|----------------|-----|
| CURB FROM PROPERTY LINE | 5m | PAVEMENT WIDTH | 10m |
|-------------------------|----|----------------|-----|

| | | | |
|-------|----------|----------------|---|
| HYDRO | 75mm DB2 | U/G CONNECTION | ✓ |
|-------|----------|----------------|---|

| | | | |
|-----------|-----------|----------------|---|
| TELEPHONE | 100mm DB2 | U/G CONNECTION | ✓ |
|-----------|-----------|----------------|---|


| | | | |
|-----|--------------|--|--|
| GAS | 42 PROP/P.E. | | |
|-----|--------------|--|--|

Information Sheets: REF. DWGS. L&M ENGINEERING LTD. JOB. 1432-01-04 DWGS.

| | | | | |
|-----------|------------------------------|---|--|-------------------|
| Comments: | CS CURB STOP CO CLEAN OUT | SDW WATER SERVICE STORM SERVICE SANITARY SERVICE | HYDRO SERVICE CABLE SERVICE TELECOMMUNICATIONS | GAS ELECTRICAL |
|-----------|------------------------------|---|--|-------------------|

THE INFORMATION CONTAINED HEREIN IS FOR INTERNAL USE ONLY.

NOT TO BE RELIED UPON UNLESS CONFIRMED BY THE SITE INSPECTION AND/OR INVESTIGATION

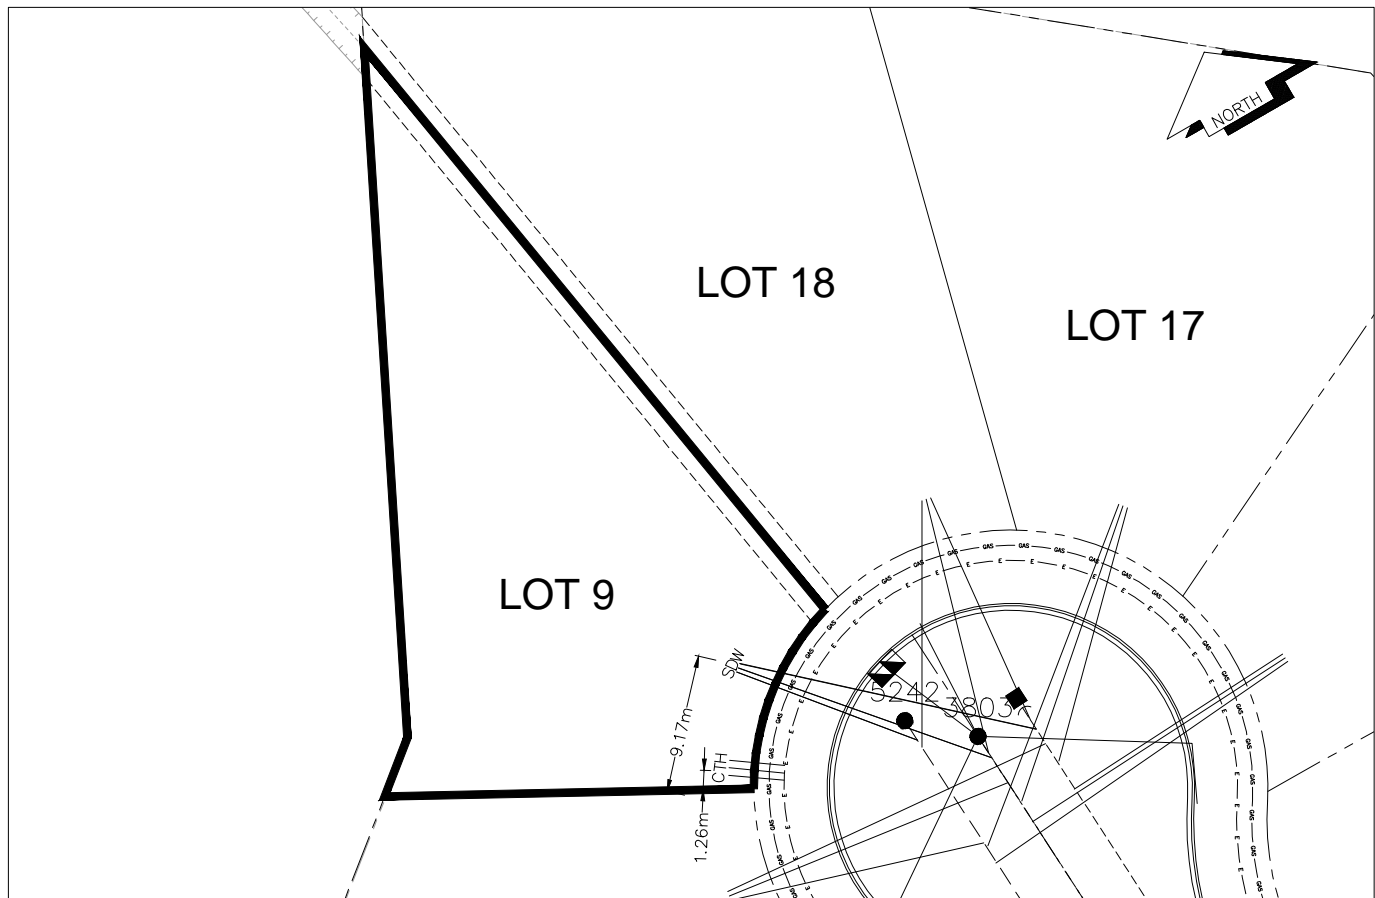

| SANITARY, STORM & WATER SERVICE INVERTS | SANITARY | WATER | STORM |
|---|----------|---------|---------|
| 1. Distance from San. M.H. <u>5241</u> toward San. M.H. <u>5242</u> to lot service connection point is: | 37.65m | N/A | N/A |
| 1a.Distance from Stm. M.H. <u>3802</u> toward Stm. M.H. <u>3803</u> to lot service connection point is: | N/A | N/A | 38.04m |
| 2. Main Size at connection point is | 200mmØ | 200mmØ | 300mmØ |
| 3. Invert of service at main conn. stub point is | 644.89m | 644.54m | 644.93m |
| 4. Invert at service end is | 645.32m | 644.83m | 645.32m |
| 5. Cover at property line in meters | 2.19m | 2.75m | 2.17m |
| 6. Survey Date: JUNE 2013 Book Ref.: 1432-01-04 By: L&M ENGINEERING LTD | | | |
| | | | |
| | | | |
SANITARY HISTORY:

DATE INSTALLED: JUNE 2013

INSTALLED BY: SUNLAND UTILITIES LTD

WATER HISTORY:

DATE INSTALLED: JUNE 2013

INSTALLED BY: SUNLAND UTILITIES LTD.

STORM HISTORY:

DATE INSTALLED: JUNE 2013

INSTALLED BY: SUNLAND UTILITIES LTD.