



# City of Prince George History Sheet

PID:	029246075
MU:	101321
WO:	66192/66193
	66194

Civic Address: 4159 Barnes Dr

Legal Description: Lot: 1 District Lot: 9261 Plan: EPP22518


Service Type	Diameter (mm)	Material	Invert Elev at main (m)	Invert Elev at property line (m)	Invert Elev at service end (m)	Distance into property (m)	Installation Date
Sanitary	100mm	PVC	-	-	-	-	August 2012
Water	20mm	Copper	-	-	-	-	August 2012
Storm	100mm	PVC	-	-	-	-	August 2012

Service Connection Location			Sanitary (m)	Storm (m)
San service connected to San MH	3647		N/A	
Stm service connected to Stm MH	1837			N/A

Power	Size	Communications	Size	Cable	Size	Gas	Size
BC Hydro	-	Telus	-	Shaw	-	FortisBC	-
Underground Service		Underground Service		Underground Service			

Installed by:	City of Prince George forces	Survey Date:	-
Comments:	Water, Sanitary and Storm locations confirmed by UTOPS August 28, 2017		

**NOT TO SCALE** The information contained herein is for internal use only.  
Not to be relied on unless confirmed by site inspection and/or investigation.

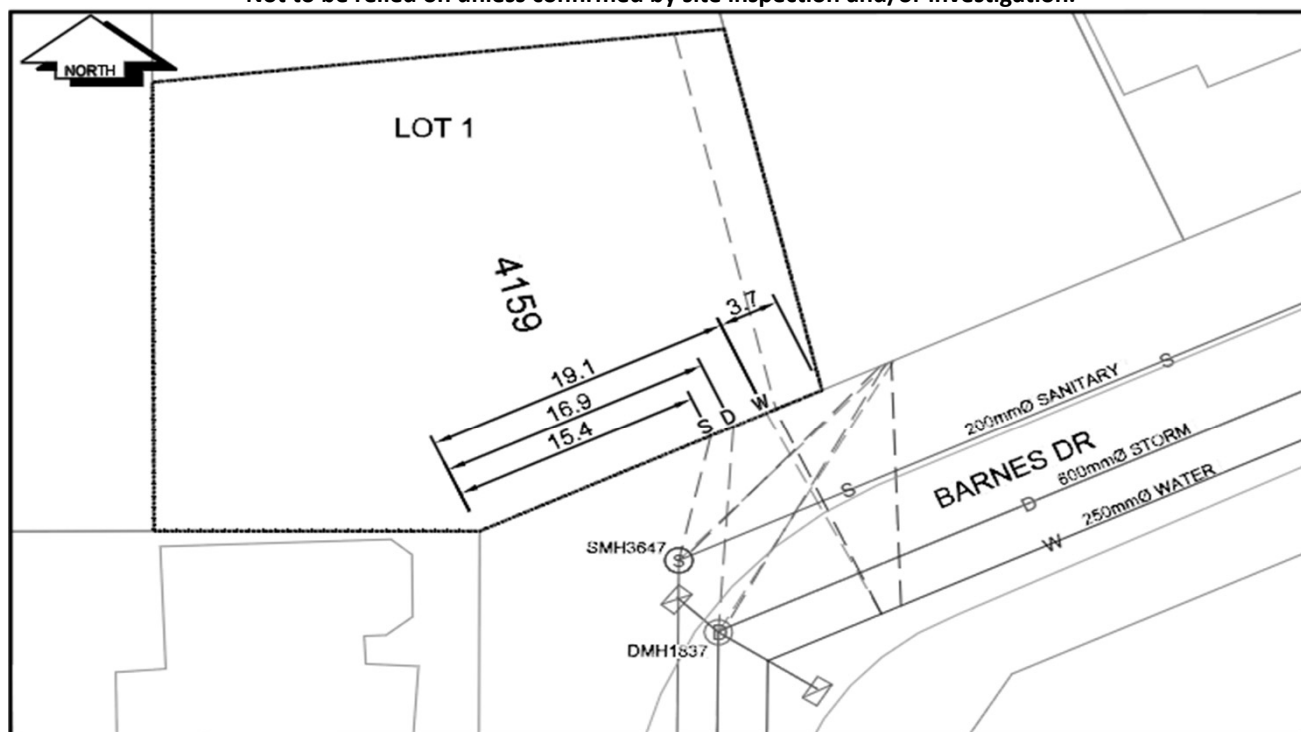

CS CURB STOP	--- WATER SERVICE	--- STORM SERVICE
CO CLEAN OUT	--- SANITARY SERVICE	--- GAS
WATER VALVE	--- FIRE HYDRANT	--- ENCUMBRANCE

**NOT TO SCALE**