

City of Prince George

HISTORY SHEET

PID: **029253101**

Scale: 1:500

Legal: LOT 1

D.L.: 2003

PLAN: EPP31607

Address: **4712 GANNETT RD**

Sanitary Connection:#	SIZE: 100mmØ	MATERIAL: PVC	INV. 673.97m	CONNECTED
-----------------------	--------------	---------------	--------------	-----------

Water Connection:#	SIZE: 19mmØ	MATERIAL: Copper	INV. 674.02m	METER
--------------------	-------------	------------------	--------------	-------

Storm Connection:#	SIZE 100mmØ	MATERIAL PVC	INV. 673.96m	CONNECTED
--------------------	-------------	--------------	--------------	-----------

Cash Receipt No's:	WATER	SANITARY	STORM
--------------------	-------	----------	-------

CURB FROM PROPERTY LINE	3m	PAVEMENT WIDTH	10m
-------------------------	----	----------------	-----

HYDRO	75mm DB2	U/G CONNECTION	✓
-------	----------	----------------	---

TELEPHONE	100mm DB2	U/G CONNECTION	✓
-----------	-----------	----------------	---


GAS	42 PROP/P.E.
-----	--------------

Information Sheets: REFERENCE DRAWINGS L&M ENGINEERING LIMITED JOB NO. 1265-01-04

Comments:

CS CURB STOP	SDW	WATER SERVICE	HYDRO SERVICE	GAS
CO CLEAN OUT		STORM SERVICE	CABLE SERVICE	ELECTRICAL
		SANITARY SERVICE	TELECOMMUNICATIONS	

**THE INFORMATION CONTAINED HEREIN IS FOR INTERNAL USE ONLY.
NOT TO BE RELIED UPON UNLESS CONFIRMED BY THE SITE INSPECTION AND/OR INVESTIGATION**

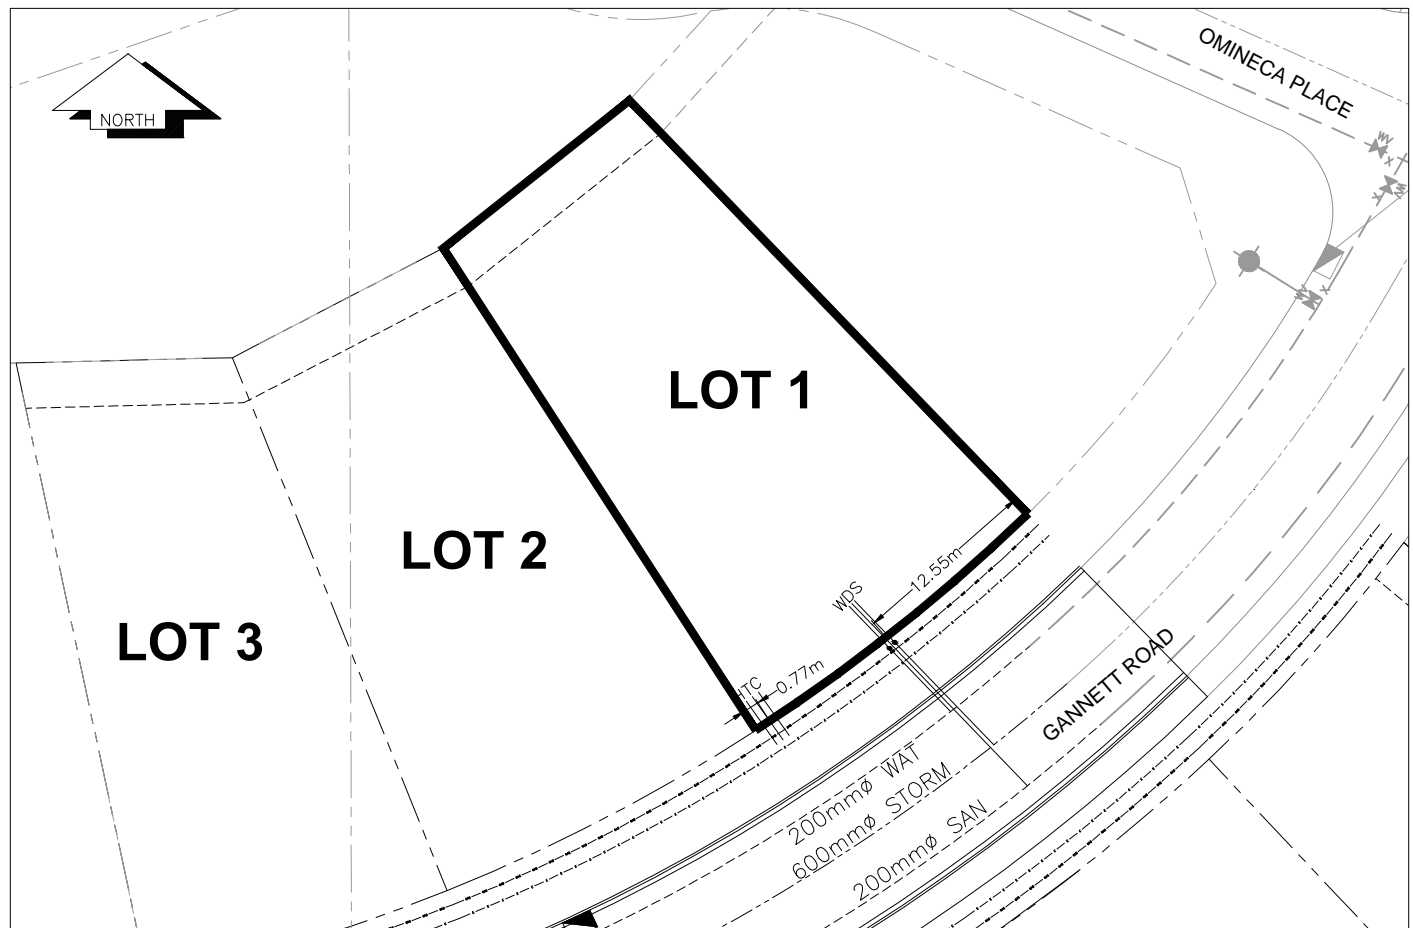

SANITARY, STORM & WATER SERVICE INVERTS	SANITARY	WATER	STORM
1. Distance from San. M.H. <u>5008</u> toward San. M.H. <u>5229</u> to lot service connection point is:	56m	N/A	N/A
1a.Distance from Stm. M.H. <u>3512</u> toward Stm. M.H. <u>3787</u> to lot service connection point is:	N/A	N/A	52m
2. Main Size at connection point is	200mmØ	200mmØ	600mmØ
3. Invert of main at conn. stub point is	673.27m	673.29m	673.27m
4. Invert at service end is	674.06m	674.03m	674.05m
5. Cut at property line in meters	2.29m	2.42m	2.34m
6. Survey Date: AUG. 2012 Book Ref.: 1265-01-04 By: SHARP CONSTRUCTION			

SANITARY HISTORY:

DATE INSTALLED: AUGUST 2012

INSTALLED BY: SHARP CONSTRUCTION

WATER HISTORY:

DATE INSTALLED: AUGUST 2012

INSTALLED BY: SHARP CONSTRUCTION

STORM HISTORY:

DATE INSTALLED: AUGUST 2012

INSTALLED BY: SHARP CONSTRUCTION