

City of Prince George

HISTORY SHEET

PID: **029253128**

Scale: 1:500

Legal: LOT 3

D.L.: 2003

PLAN: EPP31607


Address: **4724 GANNETT RD**

Sanitary Connection:#	SIZE: 100mmØ	MATERIAL: PVC	INV. 676.09m	CONNECTED
Water Connection:#	SIZE: 19mmØ	MATERIAL: Copper	INV. 676.26m	METER
Storm Connection:#	SIZE: 100mmØ	MATERIAL: PVC	INV. 676.11m	CONNECTED
Cash Receipt No's:	WATER	SANITARY	STORM	
CURB FROM PROPERTY LINE	3m	PAVEMENT WIDTH	10m	
HYDRO	75mm DB2	U/G CONNECTION	✓	
TELEPHONE	100mm DB2	U/G CONNECTION	✓	
GAS	42 PROP/P.E.			

Information Sheets: REFERENCE DRAWINGS L&M ENGINEERING LIMITED JOB NO. 1265-01-04

Comments: CS CURB STOP CO CLEAN OUT SOW WATER SERVICE STORM SERVICE SANITARY SERVICE HYDRO SERVICE CABLE SERVICE TELECOMMUNICATIONS GAS ELECTRICAL

THE INFORMATION CONTAINED HEREIN IS FOR INTERNAL USE ONLY.
NOT TO BE RELIED UPON UNLESS CONFIRMED BY THE SITE INSPECTION AND/OR INVESTIGATION

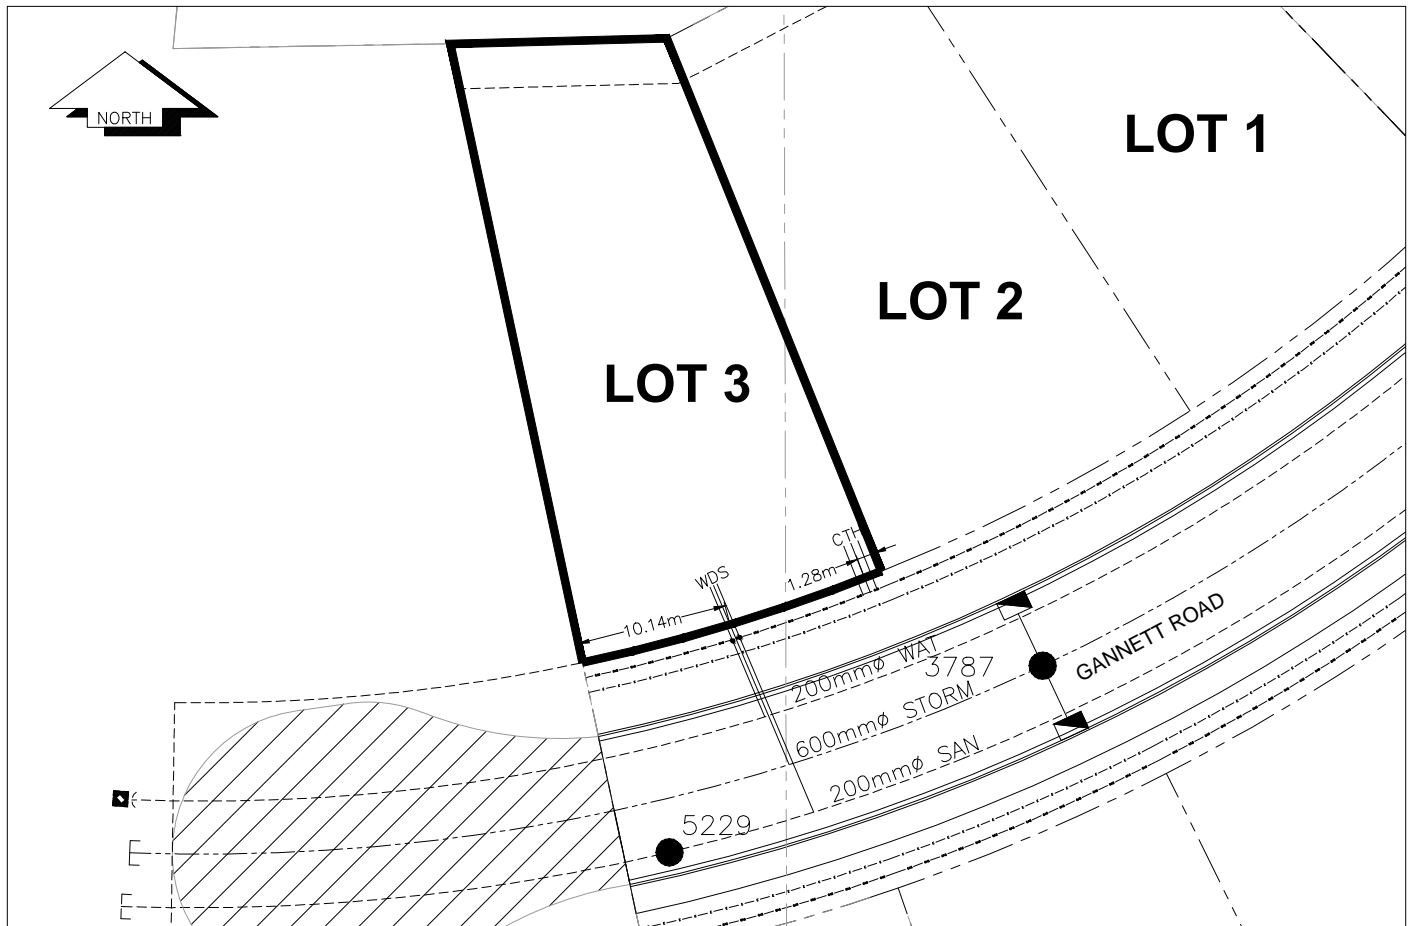

[illegible]

DATE INSTALLED: AUGUST 2012

INSTALLED BY: SHARP CONSTRUCTION

[illegible]