

City of Prince George

HISTORY SHEET

PID: **029253136**

Scale: 1:500

Legal: LOT 4

D.L.: 2003

PLAN: EPP31607

Address: **4723 GANNETT RD**

Sanitary Connection:#	SIZE: 100mmØ	MATERIAL: PVC	INV. 675.76m	CONNECTED
-----------------------	--------------	---------------	--------------	-----------

Water Connection:#	SIZE: 19mmØ	MATERIAL: Copper	INV. 675.82m	METER
--------------------	-------------	------------------	--------------	-------

Storm Connection:#	SIZE: 100mmØ	MATERIAL: PVC	INV. 675.77m	CONNECTED
--------------------	--------------	---------------	--------------	-----------

Cash Receipt No's:	WATER	SANITARY	STORM
--------------------	-------	----------	-------

CURB FROM PROPERTY LINE	3m	PAVEMENT WIDTH	10m
-------------------------	----	----------------	-----

HYDRO	75mm DB2	U/G CONNECTION	✓
-------	----------	----------------	---


TELEPHONE	100mm DB2	U/G CONNECTION	✓
-----------	-----------	----------------	---

GAS	42 PROP/P.E.		
-----	--------------	--	--

Information Sheets: REFERENCE DRAWINGS L&M ENGINEERING LIMITED JOB NO. 1265-01-04

Comments: CS CURB STOP CO CLEAN OUT SOW WATER SERVICE STORM SERVICE SANITARY SERVICE HYDRO SERVICE CABLE SERVICE TELECOMMUNICATIONS GAS ELECTRICAL

THE INFORMATION CONTAINED HEREIN IS FOR INTERNAL USE ONLY.
NOT TO BE RELIED UPON UNLESS CONFIRMED BY THE SITE INSPECTION AND/OR INVESTIGATION

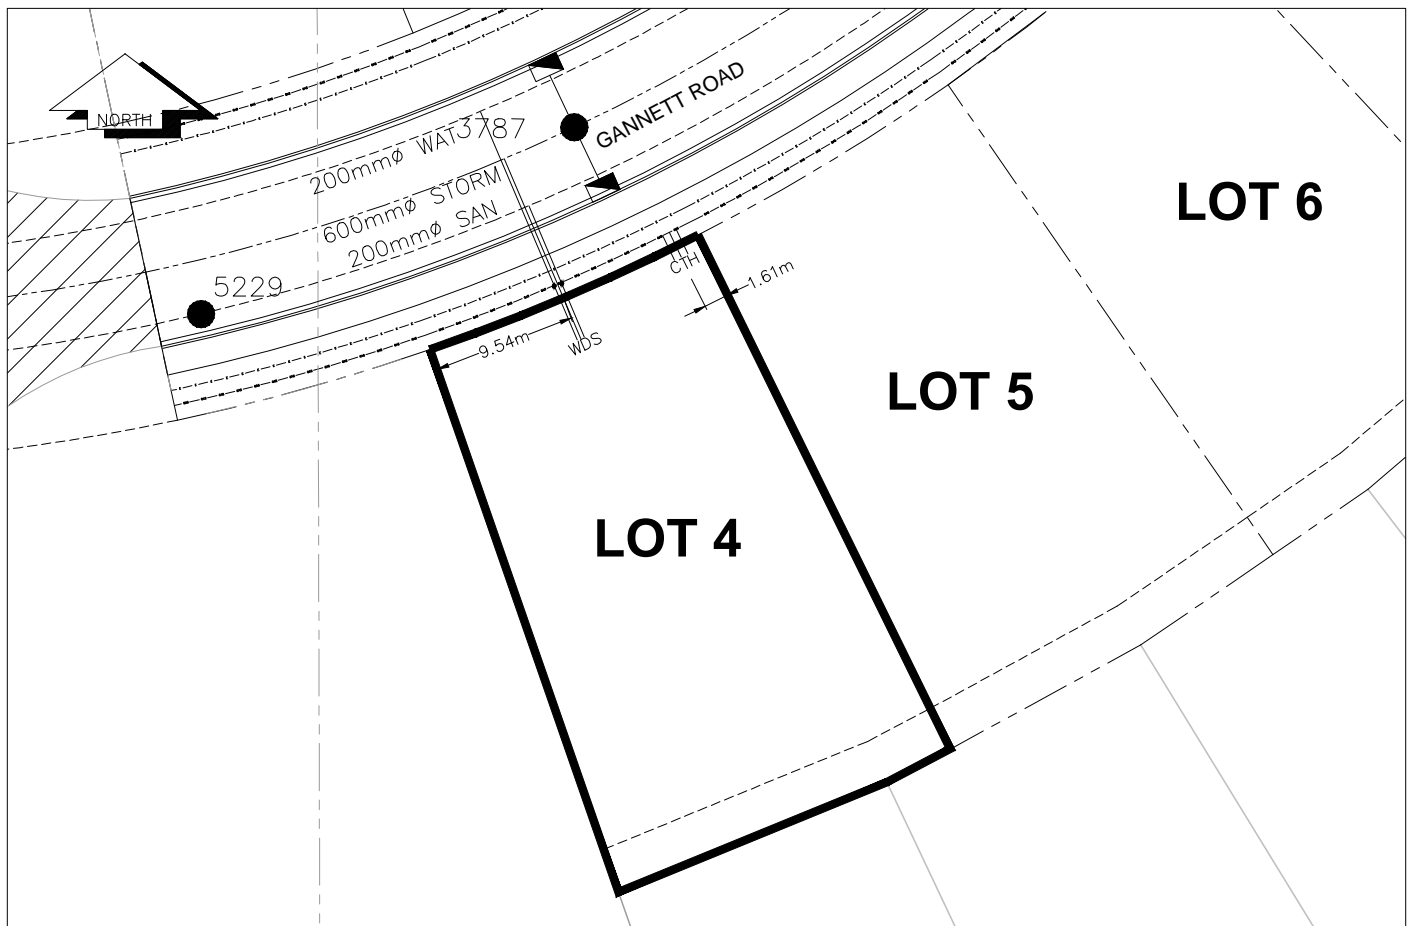

[illegible]

DATE INSTALLED: AUGUST 2012

INSTALLED BY: SHARP CONSTRUCTION

[illegible]