

City of Prince George

HISTORY SHEET

PID: **029253144**

Scale: 1:500

Legal: LOT 5

D.L.: 2003

PLAN: EPP31607

Address: **4717 GANNETT RD**

Sanitary Connection:#	SIZE: 100mmØ	MATERIAL: PVC	INV. 674.89m	CONNECTED
-----------------------	--------------	---------------	--------------	-----------

Water Connection:#	SIZE: 19mmØ	MATERIAL: Copper	INV. 674.93m	METER
--------------------	-------------	------------------	--------------	-------

Storm Connection:#	SIZE: 100mmØ	MATERIAL: PVC	INV. 674.59m	CONNECTED
--------------------	--------------	---------------	--------------	-----------

Cash Receipt No's:	WATER	SANITARY	STORM
--------------------	-------	----------	-------

CURB FROM PROPERTY LINE	3m	PAVEMENT WIDTH	10m
-------------------------	----	----------------	-----

HYDRO	75mm DB2	U/G CONNECTION	✓
-------	----------	----------------	---


TELEPHONE	100mm DB2	U/G CONNECTION	✓
-----------	-----------	----------------	---

GAS	42 PROP/P.E.		
-----	--------------	--	--

Information Sheets: REFERENCE DRAWINGS L&M ENGINEERING LIMITED JOB NO. 1265-01-04

Comments: CS CURB STOP CO CLEAN OUT SOW WATER SERVICE STORM SERVICE SANITARY SERVICE HYDRO SERVICE CABLE SERVICE TELECOMMUNICATIONS GAS ELECTRICAL

THE INFORMATION CONTAINED HEREIN IS FOR INTERNAL USE ONLY.
NOT TO BE RELIED UPON UNLESS CONFIRMED BY THE SITE INSPECTION AND/OR INVESTIGATION

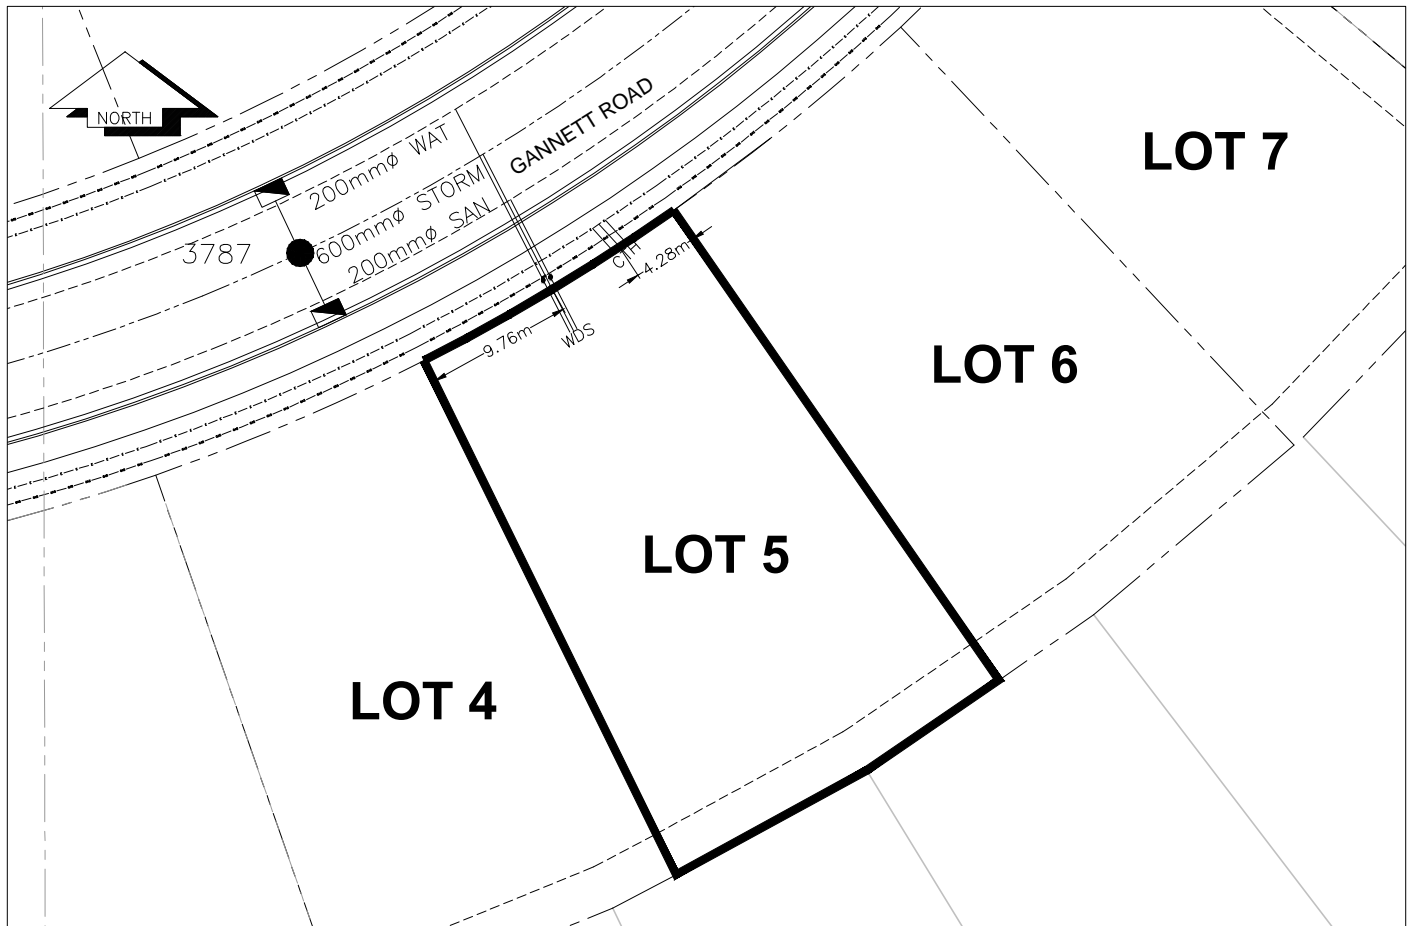

SANITARY, STORM & WATER SERVICE INVERTS	SANITARY	WATER	STORM
1. Distance from San. M.H. <u>5008</u> toward San. M.H. <u>5229</u> to lot service connection point is:	74m	N/A	N/A
1a.Distance from Stm. M.H. <u>3512</u> toward Stm. M.H. <u>3787</u> to lot service connection point is:	N/A	N/A	68m
2. Main Size at connection point is	200mmØ	200mmØ	600mmØ
3. Invert of main at conn. stub point is	674.00m	673.85m	674.32m
4. Invert at service end is	674.90m	675.05m	674.99m
5. Cut at property line in meters	2.21m	2.29m	2.52m
6. Survey Date: AUG. 2012 Book Ref.: 1265-01-04 By: SHARP CONSTRUCTION			

SANITARY HISTORY:

DATE INSTALLED: AUGUST 2012

INSTALLED BY: SHARP CONSTRUCTION

WATER HISTORY:

DATE INSTALLED: AUGUST 2012

INSTALLED BY: SHARP CONSTRUCTION

STORM HISTORY:

DATE INSTALLED: AUGUST 2012

INSTALLED BY: SHARP CONSTRUCTION