

City of Prince George

HISTORY SHEET

PID: **029253161**

Scale: 1:500

Legal: LOT 7

D.L.: 2003

PLAN: EPP31607

Address: **4705 GANNETT RD**

Sanitary Connection:#	SIZE:	100mmØ	MATERIAL:	PVC	INV.	673.46m	CONNECTED
-----------------------	-------	--------	-----------	-----	------	---------	-----------

Water Connection:#	SIZE:	19mmØ	MATERIAL:	Copper	INV.	673.29m	METER
--------------------	-------	-------	-----------	--------	------	---------	-------

Storm Connection:#	SIZE	100mmØ	MATERIAL	PVC	INV.	673.37m	CONNECTED
--------------------	------	--------	----------	-----	------	---------	-----------

Cash Receipt No's:	WATER	SANITARY	STORM
--------------------	-------	----------	-------

CURB FROM PROPERTY LINE	3m	PAVEMENT WIDTH	10m
-------------------------	----	----------------	-----

HYDRO	75mm DB2	U/G CONNECTION	✓
-------	----------	----------------	---


TELEPHONE	100mm DB2	U/G CONNECTION	✓
-----------	-----------	----------------	---

GAS	42 PROP/P.E.
-----	--------------

Information Sheets: REFERENCE DRAWINGS L&M ENGINEERING LIMITED JOB NO. 1265-01-04

Comments:	CS CURB STOP CO CLEAN OUT	SDW WATER SERVICE STORM SERVICE SANITARY SERVICE	HYDRO SERVICE CABLE SERVICE TELECOMMUNICATIONS	GAS ELECTRICAL
-----------	------------------------------	---	--	-------------------

**THE INFORMATION CONTAINED HEREIN IS FOR INTERNAL USE ONLY.
NOT TO BE RELIED UPON UNLESS CONFIRMED BY THE SITE INSPECTION AND/OR INVESTIGATION**

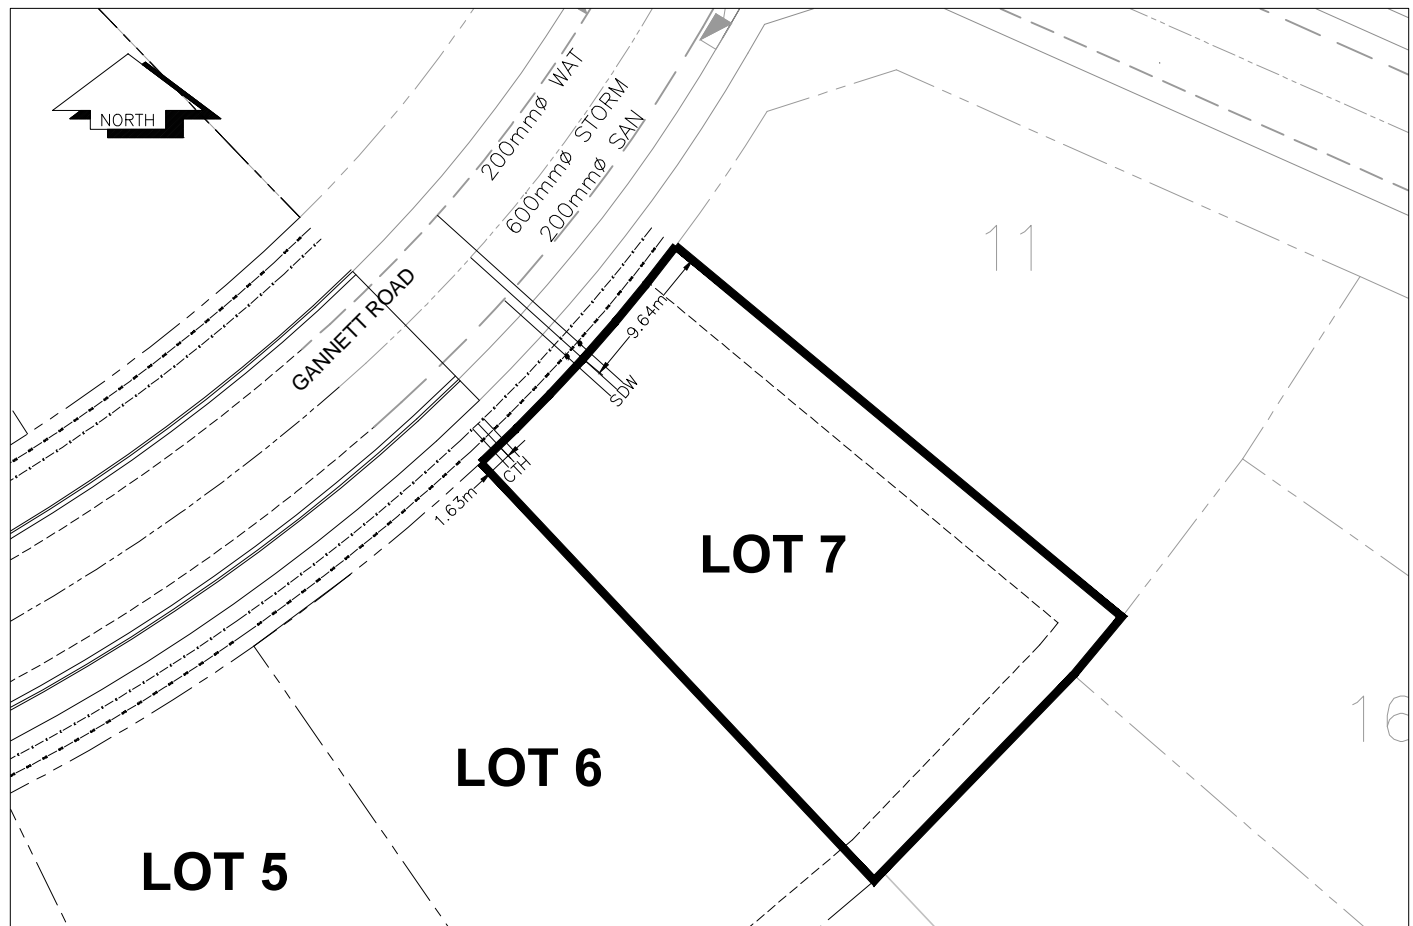

[illegible]

DATE INSTALLED: AUGUST 2012

INSTALLED BY: SHARP CONSTRUCTION

[illegible]