



# City of Prince George History Sheet

PID:	029254205
SD/MU:	
WO:	73158

Civic Address: 6744 / 6760 Madill Rd

Legal Description: Lot: 1 District Lot: 4047 Plan: EPP26104


Service Type	Diameter	Material	Invert Elev at main	Invert Elev at PL/ROW line	Invert Elev service end	Distance into property	Installation Date
Sanitary	100mm	PVC	734.68	735.00	2.00	0.00	October 2013
Water	50mm	Copper	-	-	-	-	September 2013
Storm	200mm	PVC	735.52	735.57	735.68	-	September 2013

Service Connection Location				Sanitary	Storm
Distance from downstream San MH	359	towards upstream San MH	357	71.8m	
375mm Storm service connected to Stm MH 3982					

Power	Size	Communications	Size	Cable	Size	Gas	Size
BC Hydro	-	Telus	-	Shaw	-	FortisBC	-
Underground Service		Underground Service		Underground Service			

Installed by:	City of Prince George forces	Survey Date:	
Comments:	Services locations confirmed September 2016.		

**NOT TO SCALE** The information contained herein is for internal use only.  
Not to be relied on unless confirmed by site inspection and/or investigation.

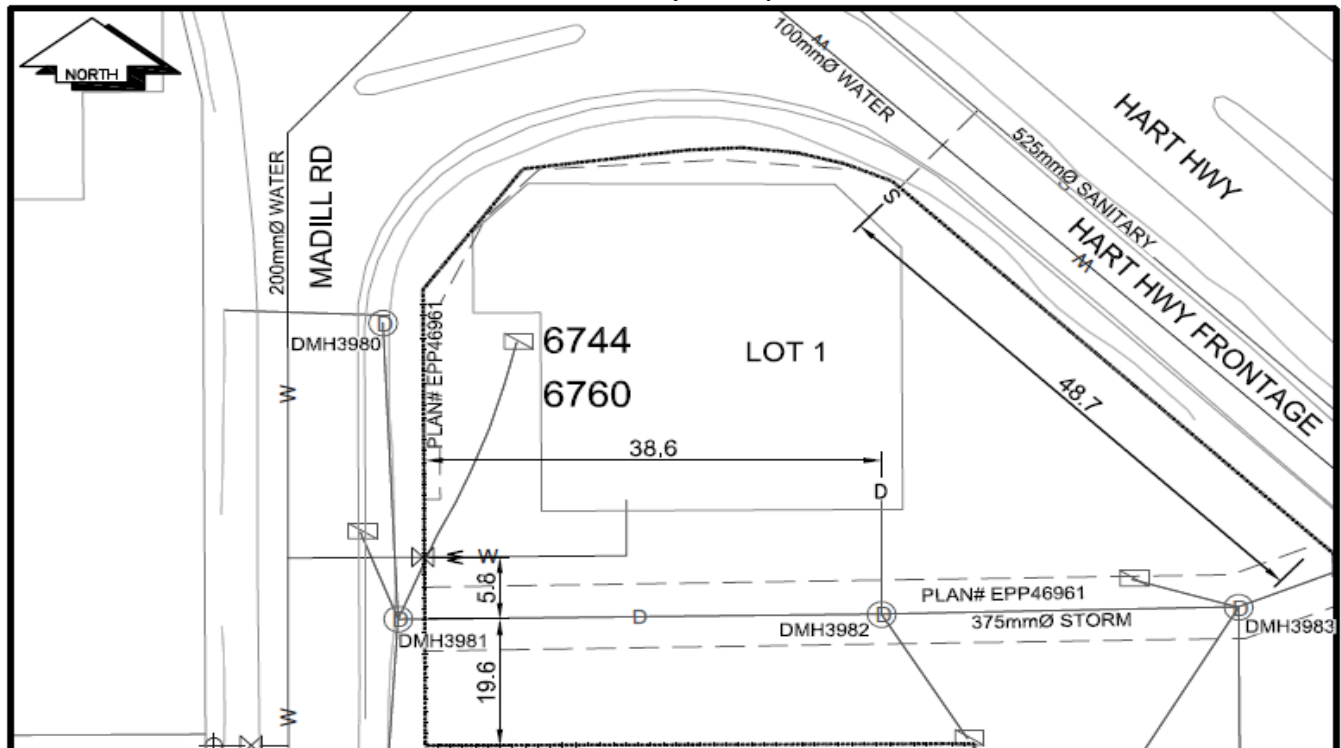

LEGEND:	CS CURB STOP	--- WATER SERVICE	--- STORM SERVICE
	CO CLEAN OUT	--- SANITARY SERVICE	--- G GAS

**NOT TO SCALE**