



City of Prince George
History Sheet

PID:	029260361
SD/MU:	
WO:	

Civic Address: 1338 Central St E

Legal Description: Lot: PCL E (BB3018438) Block: 55 District Lot: 936 Plan: 696


Service Type	Diameter (mm)	Material	Invert Elev at main (m)	Depth of cut at property line (m)	Invert Elev at service end (m)	Distance into property (m)	Installation Date
Sanitary	100mm	PVC	-	1.98	598.49	3.00	October 1961
Water	20mm	Copper	-	-	-	-	October 1961
Storm	N/A	N/A	-	-	-	-	-

Service Connection Location				Sanitary (m)	Storm (m)
Distance from downstream San MH	716	towards upstream San MH	711	27.40	
Distance from downstream Stm MH	-	towards upstream Stm MH	-		

Power	Size	Communications	Size	Cable	Size	Gas	Size
BC Hydro	-	Telus	-	Shaw	-	FortisBC	-
Overhead Service		Overhead Service		Overhead Service			

Installed by:	Survey Date:	-
Comments:		

NOT TO SCALE The information contained herein is for internal use only.
Not to be relied on unless confirmed by site inspection and/or investigation.

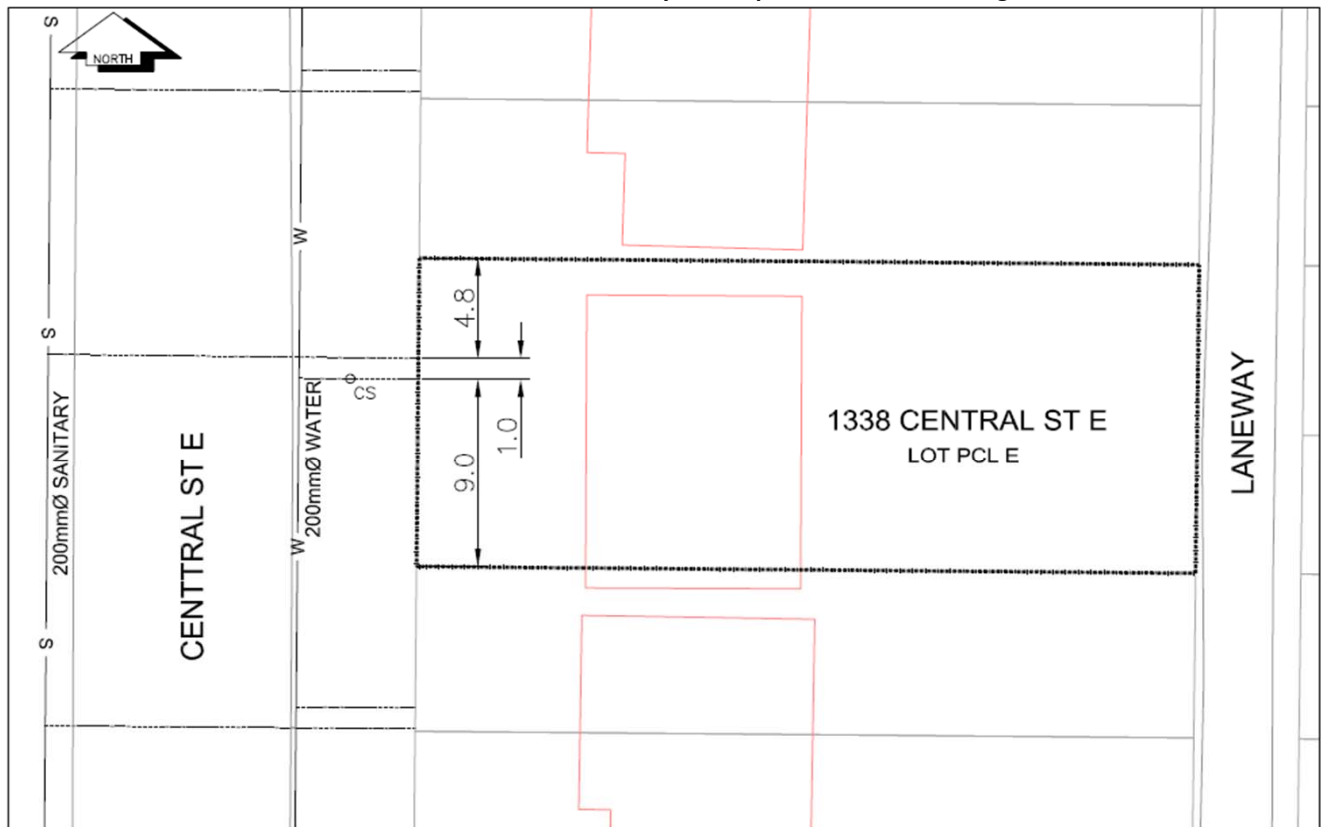

LEGEND:	CS ^o CURB STOP	--- W WATER SERVICE	--- S STORM SERVICE
	CO ^o CLEAN OUT	--- S SANITARY SERVICE	⊗ WATER VALVE

NOT TO SCALE