



# City of Prince George History Sheet

PID:	029261635
MU:	101646
WO:	84462

Civic Address: 1977 Queensway

Legal Description: Lot: PCL D (BB3018751) Block: 343 District Lot: 343 Plan: 1268


Service Type	Diameter (mm)	Material	Invert Elev at main (m)	Depth of cut at property line (m)	Invert Elev at service end (m)	Distance into property (m)	Installation Date
Sanitary (east)	100mm	AC	-	2.16	575.48	-	January 1956
Sanitary (west)	100mm	AC	-	2.59	576.03	-	January 1956
Water	50mm	Copper	-	-	-	-	September 2015
Storm	150mm	PVC	575.69	1.92	-	-	January 1963

Service Connection Location				Sanitary (m)	Storm (m)
Distance from downstream San MH	3312	towards upstream San MH	3313	25.90	
150mm Storm service connected to Stm MH on 20th Ave					-

Power	Size	Communications	Size	Cable	Size	Gas	Size
BC Hydro	-	Telus	-	Shaw	-	FortisBC	-
Overhead Service		Overhead Service		Overhead Service			

Installed by:	City of Prince George forces	Survey Date:	-
Comments:	Existing 20mm water replaced with a new 50mm water service		

**NOT TO SCALE** The information contained herein is for internal use only.  
Not to be relied on unless confirmed by site inspection and/or investigation.

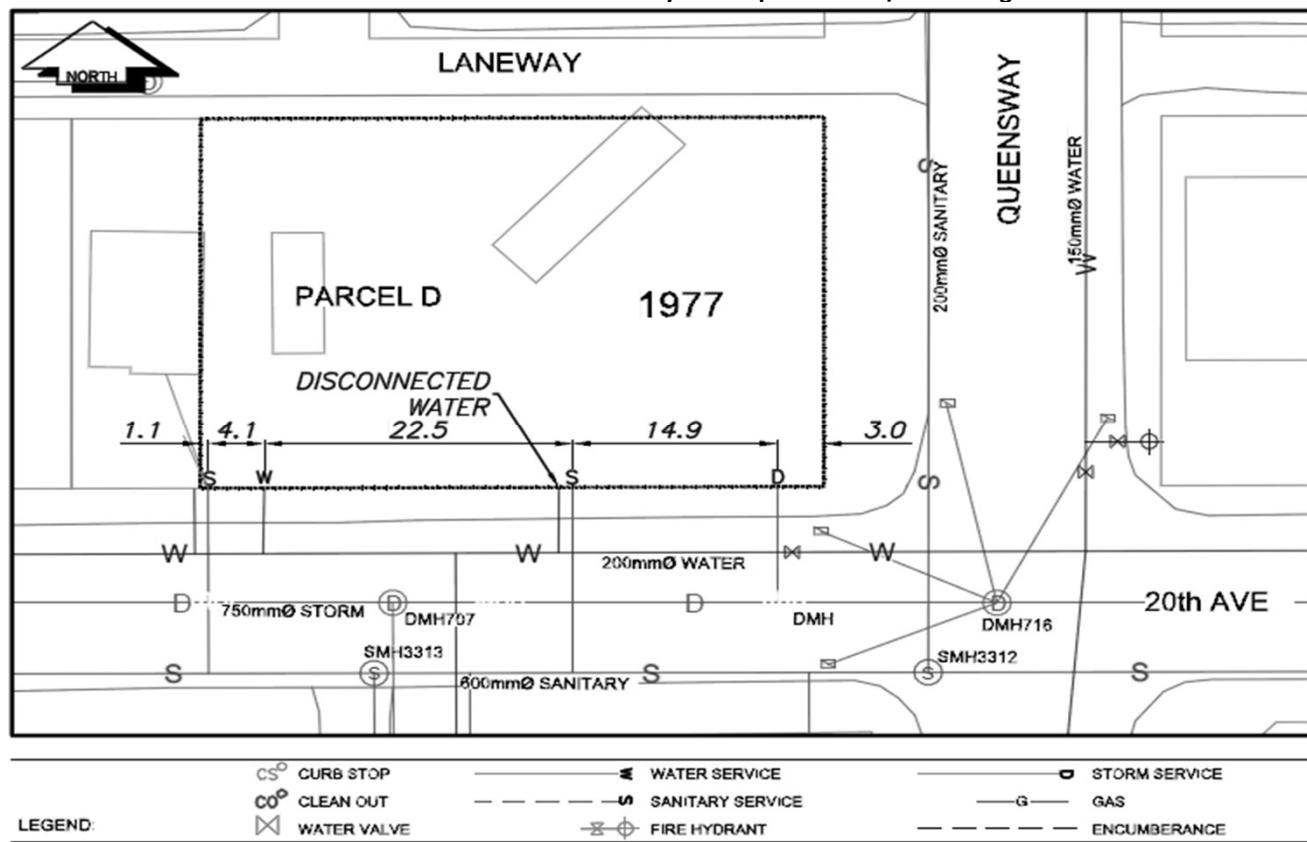

**NOT TO SCALE**