



# City of Prince George History Sheet

PID:	029262470
MU:	101545
WO:	

Civic Address: 492 Victoria St

Legal Description: Lot: PCL A CA3605796) District Lot: 343 Plan: 1268


Service Type	Diameter (mm)	Material	Invert Elev at main (m)	Depth of cut at property line (m)	Invert Depth at service end (m)	Distance into property (m)	Installation Date
Sanitary (east)	100mm	AC	-	575.83	2.01	-	January 1959
Sanitary (west)	100mm	AC	-	-	2.38	-	December 1957
Water	40mm	Copper	-	-	-	-	March 2014
Storm	N/A	N/A	-	-	-	-	

Service Connection Location				Sanitary (m)	Storm (m)
Distance from downstream San MH	2009	towards upstream San MH	2007	53.87	
Distance from downstream San MH	2009	towards upstream San MH	2007	82.30	
Distance from downstream Stm MH	-	towards upstream Stm MH	-		

Power	Size	Communications	Size	Cable	Size	Gas	Size
BC Hydro	-	Telus	-	Shaw	-	FortisBC	-
Overhead Service		Overhead Service		Overhead Service			

Installed by:	City of Prince George forces	Survey Date:	-
Comments:	20mm water services replaced in 2014 by 40mm water service - same trench install		

**NOT TO SCALE The information contained herein is for internal use only.**  
**Not to be relied on unless confirmed by site inspection and/or investigation.**

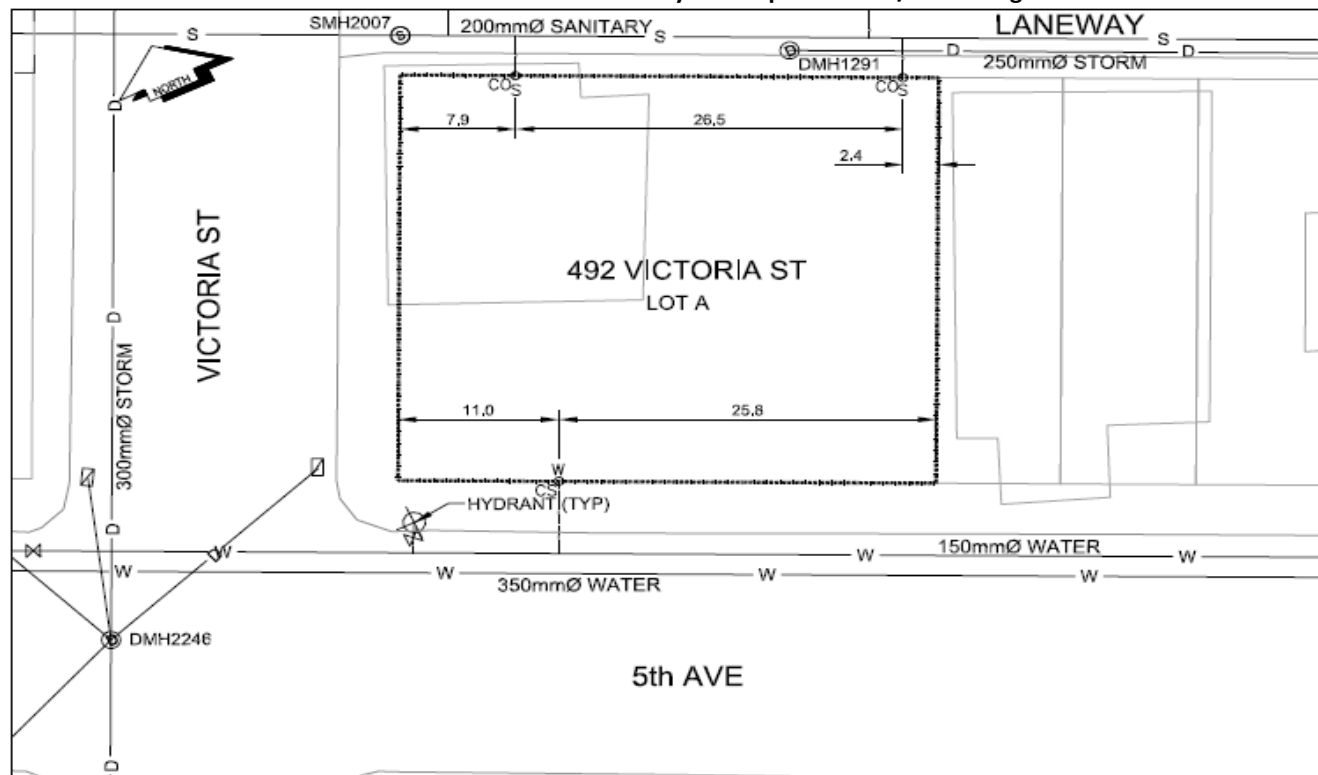

CS CURB STOP	--- WATER SERVICE	--- STORM SERVICE
CO CLEAN OUT	--- SANITARY SERVICE	⊗ WATER VALVE

NOT TO SCALE