

City of Prince George

HISTORY SHEET

PID: **029-310-270**

Scale: 1:500

Legal: LOT 3

D.L.: 2003

PLAN: EPP31288

Address: **4723 PARKSIDE DR**

| | | | | |
|-----------------------|--------------|---------------|-------------------|-----------|
| Sanitary Connection:# | SIZE: 100mmØ | MATERIAL: PVC | INV. AT R 706.40m | CONNECTED |
|-----------------------|--------------|---------------|-------------------|-----------|

| | | | | |
|--------------------|-------------|------------------|-------------------|--|
| Water Connection:# | SIZE: 19mmØ | MATERIAL: Copper | INV. AT R 706.40m | |
|--------------------|-------------|------------------|-------------------|--|

| | | | | |
|--------------------|--------------|---------------|-------------------|-----------|
| Storm Connection:# | SIZE: 100mmØ | MATERIAL: PVC | INV. AT R 706.40m | CONNECTED |
|--------------------|--------------|---------------|-------------------|-----------|

| | | | |
|--------------------|-------|----------|-------|
| Cash Receipt No's: | WATER | SANITARY | STORM |
|--------------------|-------|----------|-------|

| | | | |
|-------------------------|----|----------------|-----|
| CURB FROM PROPERTY LINE | 5m | PAVEMENT WIDTH | 10m |
|-------------------------|----|----------------|-----|

| | | | |
|-------|----------|----------------|---|
| HYDRO | 75mm DB2 | U/G CONNECTION | ✓ |
|-------|----------|----------------|---|


| | | | |
|-----------|-----------|----------------|---|
| TELEPHONE | 100mm DB2 | U/G CONNECTION | ✓ |
|-----------|-----------|----------------|---|

| | | | |
|-----|--------------|--|--|
| GAS | 42 PROP/P.E. | | |
|-----|--------------|--|--|

Information Sheets: REF. DWGS. L&M ENGINEERING LTD. JOB. 1273-17-04 DWGS.

Comments: CS CURB STOP CO CLEAN OUT SDW WATER SERVICE STORM SERVICE SANITARY SERVICE HYDRO SERVICE CABLE SERVICE TELECOMMUNICATIONS GAS ELECTRICAL

THE INFORMATION CONTAINED HEREIN IS FOR INTERNAL USE ONLY.
NOT TO BE RELIED UPON UNLESS CONFIRMED BY THE SITE INSPECTION AND/OR INVESTIGATION

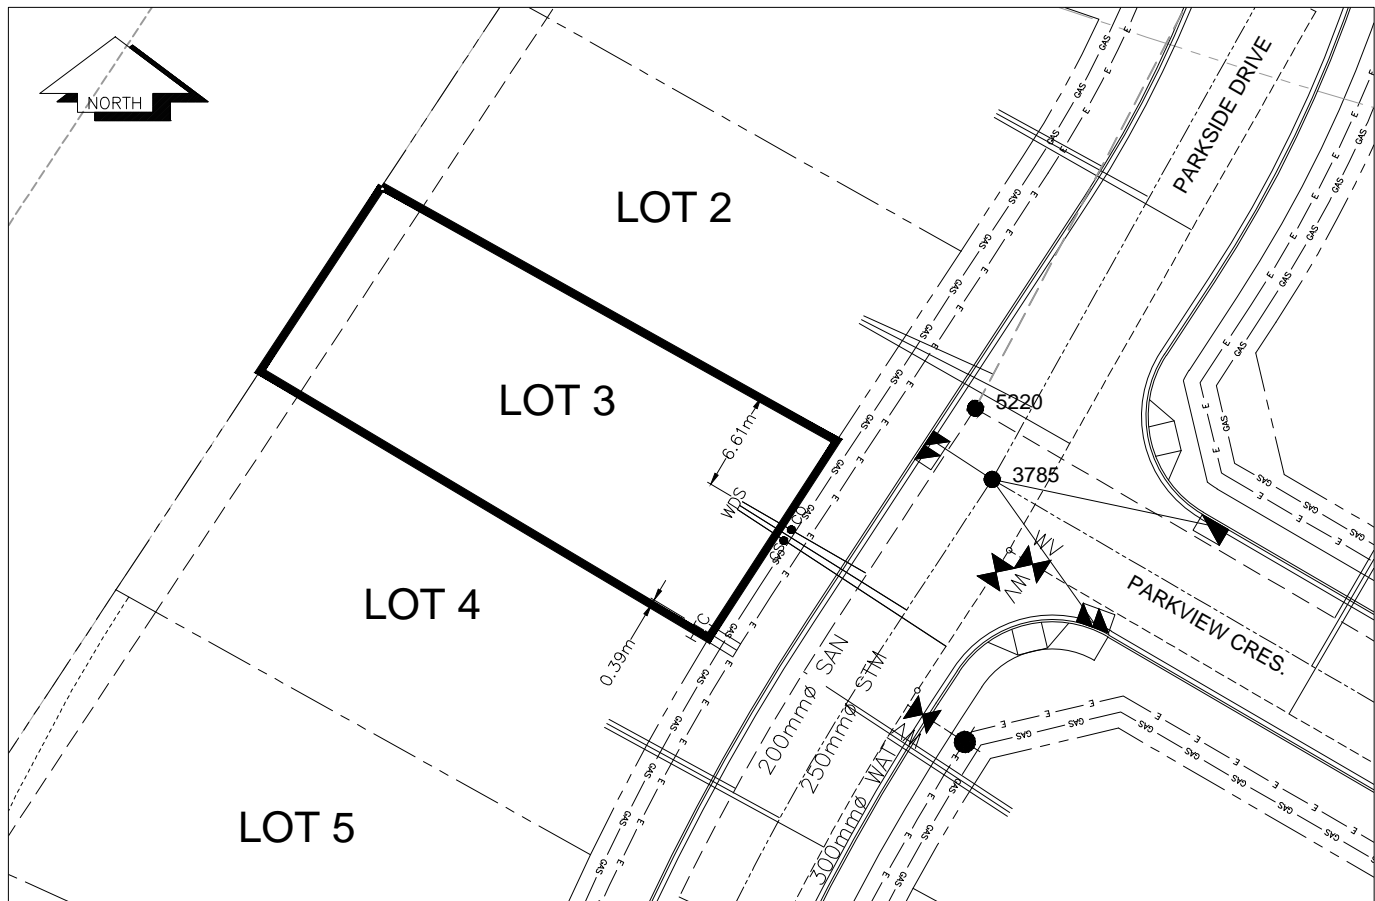

| SANITARY, STORM & WATER SERVICE INVERTS | SANITARY | WATER | STORM |
|---|----------|---------|---------|
| 1. Distance from San. M.H. <u>5220</u> toward San. M.H. <u>5222</u> to lot service connection point is: | 13.08m | N/A | N/A |
| 1a.Distance from Stm. M.H. <u>3785</u> toward Stm. M.H. <u>3783</u> to lot service connection point is: | N/A | N/A | 10.33m |
| 2. Main Size at connection point is | 200mmØ | 300mmØ | 250mmØ |
| 3. Invert of service at main conn. stub point is | 705.67m | 705.19m | 706.11m |
| 4. Invert at service end is | 706.46m | 706.46m | 706.46m |
| 5. Cover at property line in meters | 2.44m | 2.52m | 2.44m |
| 6. Survey Date: MAY 2012 Book Ref.:1273-14-04 By: L&M ENGINEERING LTD | | | |
| | | | |
| | | | |
SANITARY HISTORY:

DATE INSTALLED: JULY 2012

INSTALLED BY: SUNLAND UTILITIES LTD

WATER HISTORY:

DATE INSTALLED: JULY 2012

INSTALLED BY: SUNLAND UTILITIES LTD.

STORM HISTORY:

DATE INSTALLED: JULY 2012

INSTALLED BY: SUNLAND UTILITIES LTD.