
## City of Prince George HISTORY SHEET

| PID: <b>029-310-3</b>      | 26  |                        |        |   | Scal           | e: 1:500  |                       |
|----------------------------|---|------------------------|--------|---|----------------|---|-----------------------|
| Legal: LOT 8               |   |                        |        |   | D.L.:          | 2003  | PLAN: EPP31288        |
| Address: 4855 PAR          | KSIDE DR  |                        |        |   |                |   |                       |
| Sanitary Connection:       | <b>‡</b>  | SIZE:                  | 100mmØ | MATERIAL:                                       | PVC            | INV. AT P 711.62                                  | m CONNECTED           |
| Water Connection:#         |   | SIZE:                  | 19mmØ  | MATERIAL:                                       | Copper         | INV. AT P 711.50                                  | m                     |
| Storm Connection:#         |   | SIZE                   | 100mmØ | MATERIAL  | PVC            | INV. AT P 711.53                                  | 3m CONNECTED          |
| Cash Receipt No's:         |   |                        | WATER  |   | SANITARY       |   | STORM                 |
| CURB FROM PROPERTY LINE 5m |   |                        |        |   | PAVEMEN        | NT WIDTH 10m                                      |                       |
| HYDRO                      | 75mm D  | )B2                    |        |   | U/G CONNECTION | ON  |                       |
| TELEPHONE                  | 100mm   | DB2                    |        |   | U/G CONNECTION | ON  |                       |
| GAS                        | 42 PRO  | 42 PROP/P.E.           |        |   |                |   |                       |
| Information Sheets:        | REF. DWGS. L&M ENGINEERING LTD. JOB. 1273-17-04 DWGS. |                        |        |   |                |   |                       |
| Comments:                  | CS<br>CO  | CURB STOP<br>CLEAN OUT |        | WATER SERVICI<br>STORM SERVICI<br>SANITARY SERV | IICE =         | HYDRO SERVICE<br>CABLE SERVICE<br>TELECOMMUNICAST | GAS  FIONS ELECTRICAL |

THE INFORMATION CONTAINED HEREIN IS FOR INTERNAL USE ONLY.

NOT TO BE RELIED UPON UNLESS CONFIRMED BY THE SITE INSPECTION AND/OR INVESTIGATION

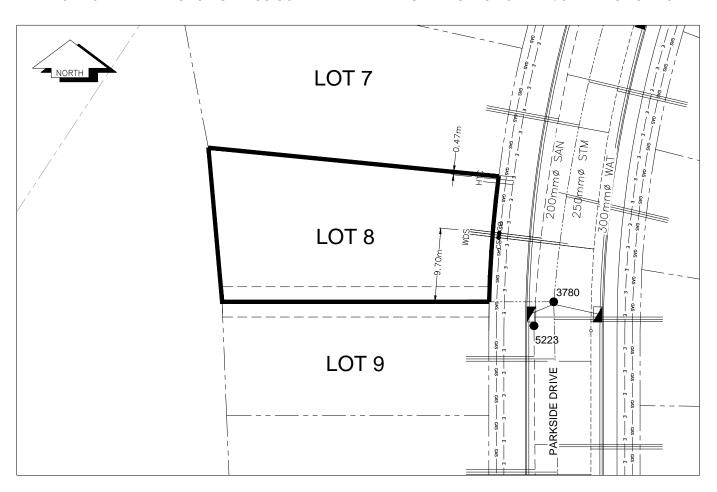

| SANITARY, STORM & WATER SERVICE INVERTS   | SANITARY | WATER   | STORM   |
|---|----------|---------|---------|
| Distance from San. M.H. <u>5222</u> toward San. M.H. <u>5223</u> to lot service connection point is:    | 35.52m   | N/A     | N/A     |
| 1a.Distance from Stm. M.H. <u>3783</u> toward Stm. M.H. <u>3780</u> to lot service connection point is: | N/A      | N/A     | 32.10m  |
| 2. Main Size at connection point is   | 200mmØ   | 300mmØ  | 250mmØ  |
| 3. Invert of service at main conn. stub point is  | 710.66m  | 710.09m | 710.88m |
| 4. Invert at service end is   | 711.68m  | 711.56m | 711.59m |
| 5. Cover at property line in meters   | 2.49m    | 2.69m   | 2.58m   |
| 6. Survey Date: MAY 2012 Book Ref.:1273-14-04 By: L&M ENGINEERING LTD                                   |          |         |         |
|   |          |         |         |
|   |          |         |         |
|   |          |         | 1       |
| SANITARY HISTORY:   |          |         |         |
| DATE INSTALLED: JULY 2012   |          |         |         |
| INSTALLED BY: SUNLAND UTILITIES LTD   |          |         |         |
|   |          |         |         |
|   |          |         |         |
| WATER HISTORY:  |          |         |         |
| DATE INSTALLED: JULY 2012   |          |         |         |
| INSTALLED BY: SUNLAND UTILITIES LTD.  |          |         |         |
| INSTALLED BY. SUNLAND UTILITIES LTD.  |          |         |         |
|   |          |         |         |
|   |          |         |         |
| STORM HISTORY:  |          |         |         |
| DATE INSTALLED: JULY 2012   |          |         |         |
| INSTALLED BY: SUNLAND UTILITIES LTD.  |          |         |         |
|   |          |         |         |
|   |          |         |         |
