

City of Prince George

HISTORY SHEET

PID: **029-310-733**

Scale: 1:500

Legal: LOT 49

D.L.: 2003

PLAN: EPP31288

Address: **4894 PARKSIDE**

Sanitary Connection:# SIZE: 100mmØ MATERIAL: PVC INV. AT \mathbb{R} 711.97m CONNECTED

Water Connection:# SIZE: 19mmØ MATERIAL: Copper INV. AT \mathbb{R} 711.93m

Storm Connection:# SIZE: 100mmØ MATERIAL: PVC INV. AT \mathbb{R} 711.94m CONNECTED

Cash Receipt No's: WATER SANITARY STORM

CURB FROM PROPERTY LINE 5m PAVEMENT WIDTH 10m

HYDRO 75mm DB2 U/G CONNECTION ✓

TELEPHONE 100mm DB2 U/G CONNECTION ✓


GAS 42 PROP/P.E.

Information Sheets: REF. DWGS. L&M ENGINEERING LTD. JOB. 1273-17-04 DWGS.

Comments: CS CURB STOP SDW WATER SERVICE SDW HYDRO SERVICE
CO CLEAN OUT SDW STORM SERVICE SDW CABLE SERVICE
SDW SANITARY SERVICE SDW TELECOMMUNICATIONS GAS
ELECTRICAL

THE INFORMATION CONTAINED HEREIN IS FOR INTERNAL USE ONLY.

NOT TO BE RELIED UPON UNLESS CONFIRMED BY THE SITE INSPECTION AND/OR INVESTIGATION

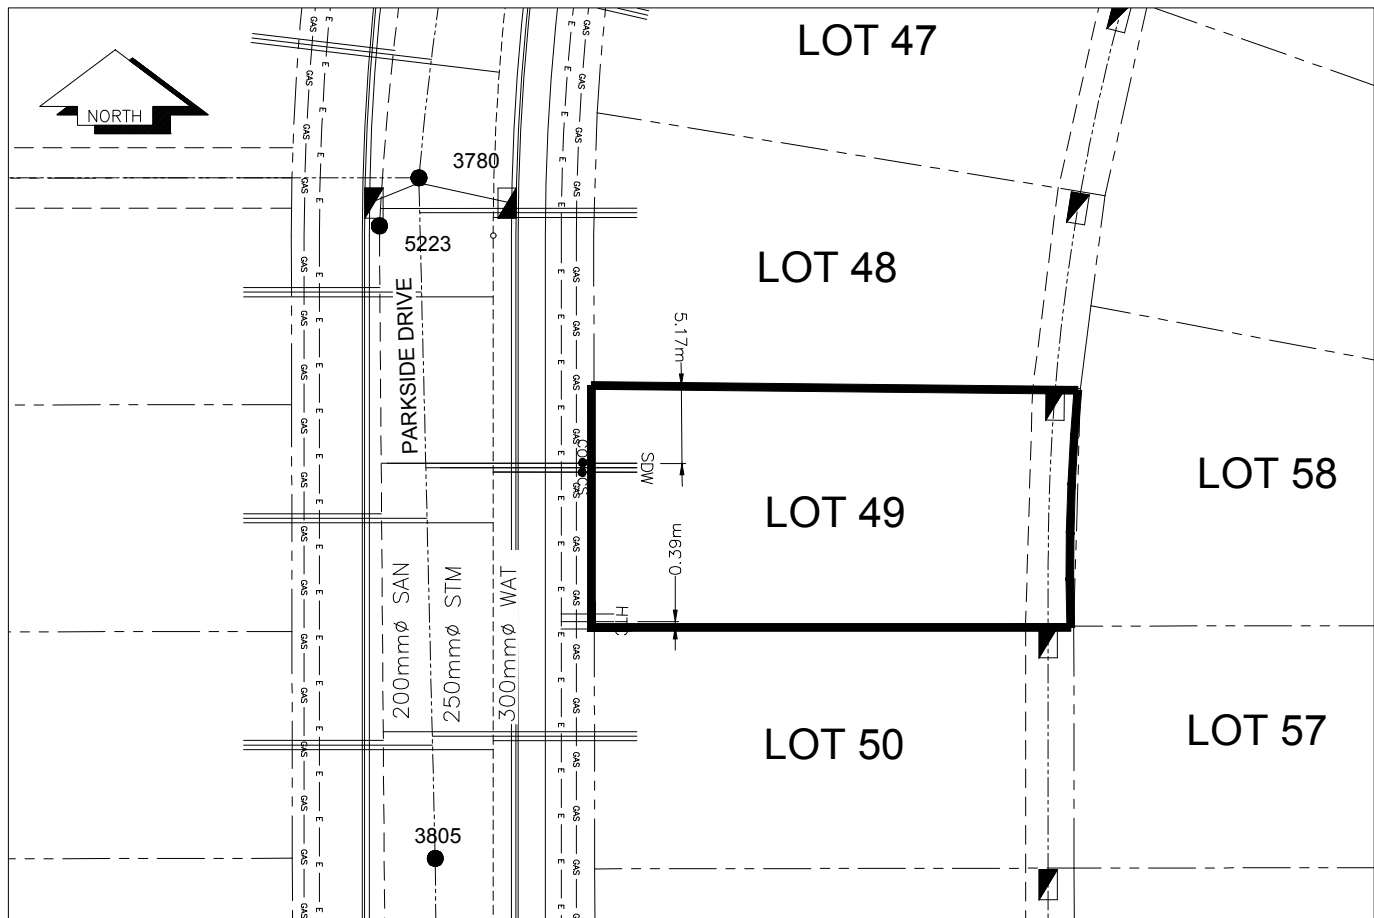

SANITARY, STORM & WATER SERVICE INVERTS	SANITARY	WATER	STORM
1. Distance from San. M.H. <u>5223</u> toward San. M.H. <u>5225</u> to lot service connection point is:	14.41m	N/A	N/A
1a.Distance from Stm. M.H. <u>3780</u> toward Stm. M.H. <u>3805</u> to lot service connection point is:	N/A	N/A	18.67m
2. Main Size at connection point is	200mmØ	300mmØ	250mmØ
3. Invert of service at main conn. stub point is	711.28m	710.85m	711.42m
4. Invert at service end is	712.03m	711.99m	712.00m
5. Cover at property line in meters	3.21m	3.33m	3.24m
6. Survey Date: MAY 2012 Book Ref.:1273-14-04 By:L&M ENGINEERING LTD			

SANITARY HISTORY:

DATE INSTALLED: JULY 2012

INSTALLED BY: SUNLAND UTILITIES LTD

SAG IN SANITARY SERVICE WAS REPAIRED BY JOE ROBERTS CONSTRUCTION LTD. JULY 2017

WATER HISTORY:

DATE INSTALLED: JULY 2012

INSTALLED BY: SUNLAND UTILITIES LTD.

STORM HISTORY:

DATE INSTALLED: JULY 2012

INSTALLED BY: SUNLAND UTILITIES LTD.

SAG IN STORM SERVICE WAS REPAIRED BY JOE ROBERTS CONSTRUCTION LTD. JULY 2017