

# City of Prince George

## HISTORY SHEET

PID: 029-310-768

Scale: 1:500

Legal: LOT 52

D.L.: 2003

PLAN: EPP31288

Address: 4958 PARKSIDE DR

Sanitary Connection:# SIZE: 100mmØ MATERIAL: PVC INV. AT R 712.09m CONNECTED

Water Connection:# SIZE: 19mmØ MATERIAL: Copper INV. AT R 712.08m

Storm Connection:# SIZE: 100mmØ MATERIAL: PVC INV. AT R 712.10m CONNECTED

Cash Receipt No's: WATER SANITARY STORM

CURB FROM PROPERTY LINE 5m PAVEMENT WIDTH 10m

HYDRO 75mm DB2 U/G CONNECTION ✓


TELEPHONE 100mm DB2 U/G CONNECTION ✓

GAS 42 PROP/P.E.

Information Sheets: REF. DWGS. L&M ENGINEERING LTD. JOB. 1273-17-04 DWGS.

Comments: CS CURB STOP SDW WATER SERVICE SDW STORM SERVICE SDW SANITARY SERVICE TOH HYDRO SERVICE TOH CABLE SERVICE TOH TELECOMMUNICATIONS GAS ELECTRICAL

THE INFORMATION CONTAINED HEREIN IS FOR INTERNAL USE ONLY.  
NOT TO BE RELIED UPON UNLESS CONFIRMED BY THE SITE INSPECTION AND/OR INVESTIGATION

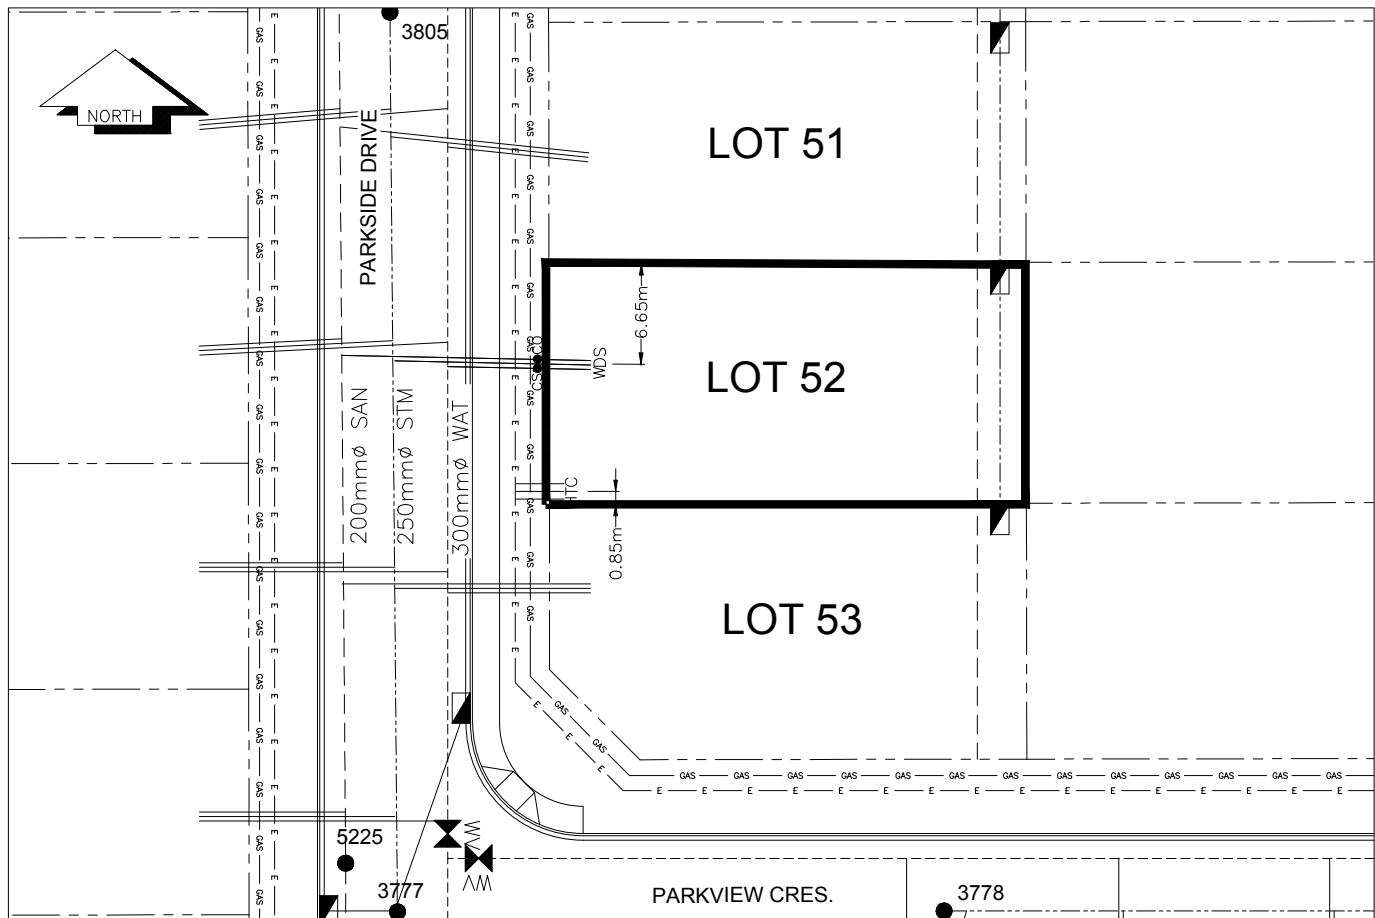

SANITARY, STORM & WATER SERVICE INVERTS	SANITARY	WATER	STORM
1. Distance from San. M.H. <u>5223</u> toward San. M.H. <u>5225</u> to lot service connection point is:	63.98m	N/A	N/A
1a.Distance from Stm. M.H. <u>3805</u> toward Stm. M.H. <u>3777</u> to lot service connection point is:	N/A	N/A	22.51m
2. Main Size at connection point is	200mmØ	300mmØ	250mmØ
3. Invert of service at main conn. stub point is	711.78m	711.23m	711.83m
4. Invert at service end is	712.15m	712.14m	712.16m
5. Cover at property line in meters	3.65m	3.74m	3.64m
6. Survey Date: MAY 2012 Book Ref.:1273-14-04 By:L&M ENGINEERING LTD			

### SANITARY HISTORY:

DATE INSTALLED: JULY 2012

INSTALLED BY: SUNLAND UTILITIES LTD

### WATER HISTORY:

DATE INSTALLED: JULY 2012

INSTALLED BY: SUNLAND UTILITIES LTD.

### STORM HISTORY:

DATE INSTALLED: JULY 2012

INSTALLED BY: SUNLAND UTILITIES LTD.