
City of Prince George HISTORY SHEET

PID: 02	29-310-857					Sca	ıle: 1:500			
Legal: LC	DT 61					D.L	.: 2003		PLAN:	EPP31288
Address: 34	117 PARKV	IEW CRE	s							
Sanitary Cor	nnection:#		SIZE:	100mmØ	MATERIAL:	PVC	INV. AT PL	707.41m	CONN	ECTED
Water Conn	ection:#		SIZE:	19mmØ	MATERIAL:	Copper	INV. AT P	707.41m		
Storm Conn	ection:#		SIZE	100mmØ	MATERIAL	PVC	INV. AT P	707.41m	CONN	ECTED
Cash Receip	pt No's:			WATER		SANITARY		SI	ГORM	
CURB FROI	M PROPER	TY LINE	5m				PA	AVEMENT W	/IDTH	10m
HYDRO		75mm D	B2			U/G CONNECT	ION ~	/		
TELEPHON	ΙΕ	100mm l	DB2			U/G CONNECT	ION ~	/		
GAS		42 PRO	P/P.E.							
Information	ormation Sheets: REF. DWGS. L&M ENGINEERING LTD. JOB. 1273-17-04 DWGS.									
Comments:		cs co	CURB STOP CLEAN OUT		WATER SERVICI STORM SERVICI SANITARY SERV	IIIIIIIIIIIIIIIIIIIIIIIIIIIIIIIIIIIIII	- HYDRO SER O CABLE SER TELECOMMU	VICE /ICE JNICASTIONS	S — ı — ı –	- GAS - ELECTRICAL

THE INFORMATION CONTAINED HEREIN IS FOR INTERNAL USE ONLY. NOT TO BE RELIED UPON UNLESS CONFIRMED BY THE SITE INSPECTION AND/OR INVESTIGATION

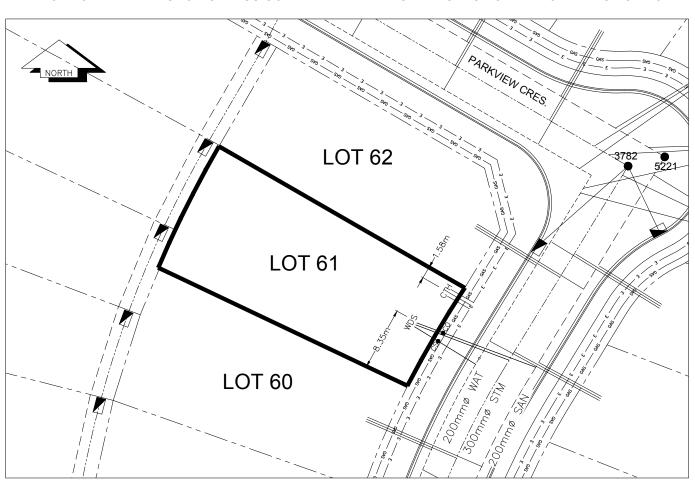

SANITARY, STORM & WATER SERVICE INVERTS	SANITARY	WATER	STORM								
1. Distance from San. M.H. <u>5227</u> toward San. M.H. <u>5221</u> to lot service connection point is:	59.35m	N/A	N/A								
1a.Distance from Stm. M.H. 3781 toward Stm. M.H. 3782 to lot service connection point is:	N/A	N/A	56.73m								
2. Main Size at connection point is	200mmØ	200mmØ	300mmØ								
3. Invert of service at main conn. stub point is	707.14m	706.53m	706.97m								
4. Invert at service end is	707.77m	707.74m	707.79m								
5. Cover at property line in meters	2.56m	2.64m	2.56m								
6. Survey Date: MAY 2012 Book Ref.:1273-14-04 By:L&M ENGINEERING LTD											
SANITARY HISTORY:											
DATE INSTALLED: JULY 2012											
INSTALLED BY: SUNLAND UTILITIES LTD											
SAG IN SANITARY SERVICE WAS REPAIRED BY JOE ROBERTS CONSTRUCTION LTD. JULY 2017											
WATER HISTORY:											
DATE INSTALLED: JULY 2012											
INSTALLED BY: SUNLAND UTILITIES LTD.											
STORM HISTORY:											
DATE INSTALLED: JULY 2012											
INSTALLED BY: SUNLAND UTILITIES LTD.											
SAG IN STORM SERVICE WAS REPAIRED BY JOE ROBERTS CONSTRUCTION LTD. JULY 2017											