

City of Prince George

HISTORY SHEET

PID: **029-310-865**

Scale: 1:500

Legal: LOT 62

D.L.: 2003

PLAN: EPP31288


Address: **3351 PARKVIEW CRES**

Sanitary Connection:#	SIZE: 100mmØ	MATERIAL: PVC	INV. AT R 707.26m	CONNECTED
Water Connection:#	SIZE: 19mmØ	MATERIAL: Copper	INV. AT R 707.26m	
Storm Connection:#	SIZE: 100mmØ	MATERIAL: PVC	INV. AT R 707.26m	CONNECTED
Cash Receipt No's:	WATER	SANITARY	STORM	
CURB FROM PROPERTY LINE	5m	PAVEMENT WIDTH	10m	
HYDRO	75mm DB2	U/G CONNECTION	✓	
TELEPHONE	100mm DB2	U/G CONNECTION	✓	
GAS	42 PROP/P.E.			

Information Sheets: REF. DWGS. L&M ENGINEERING LTD. JOB. 1273-17-04 DWGS.

Comments: CS CURB STOP CO CLEAN OUT WDS WATER SERVICE STORM SERVICE SANITARY SERVICE HYDRO SERVICE CABLE SERVICE TELECOMMUNICATIONS GAS ELECTRICAL

THE INFORMATION CONTAINED HEREIN IS FOR INTERNAL USE ONLY.
NOT TO BE RELIED UPON UNLESS CONFIRMED BY THE SITE INSPECTION AND/OR INVESTIGATION

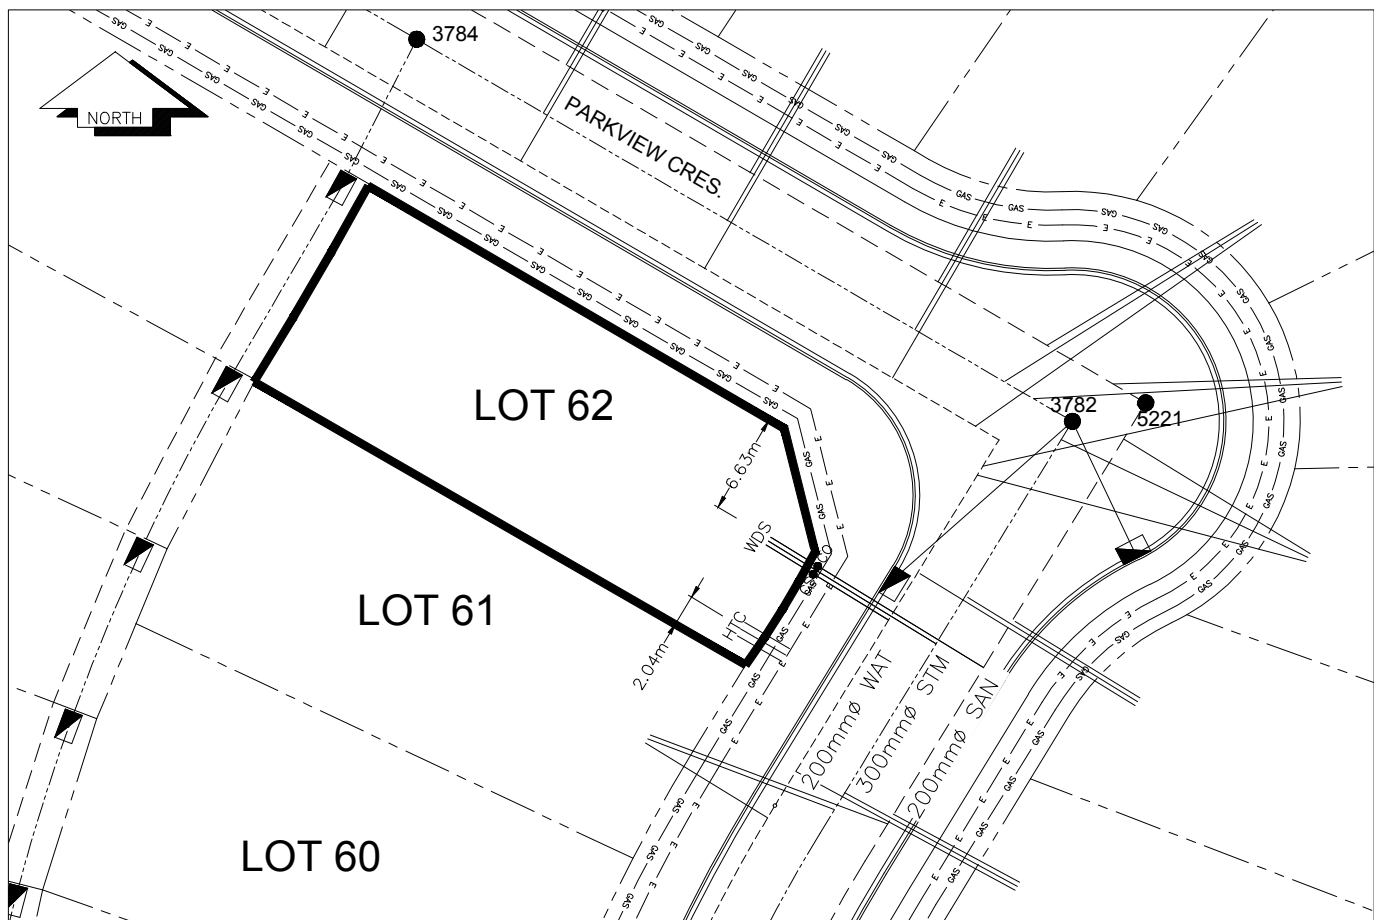

SANITARY, STORM & WATER SERVICE INVERTS	SANITARY	WATER	STORM
1. Distance from San. M.H. <u>5227</u> toward San. M.H. <u>5221</u> to lot service connection point is:	70.37m	N/A	N/A
1a.Distance from Stm. M.H. <u>3781</u> toward Stm. M.H. <u>3782</u> to lot service connection point is:	N/A	N/A	68.35m
2. Main Size at connection point is	200mmØ	200mmØ	300mmØ
3. Invert of service at main conn. stub point is	706.88m	706.23m	706.68m
4. Invert at service end is	707.30m	707.33m	707.35m
5. Cover at property line in meters	2.35m	2.43m	2.35m
6. Survey Date: MAY 2012 Book Ref.:1273-14-04 By:L&M ENGINEERING LTD			

SANITARY HISTORY:

DATE INSTALLED: JULY 2012

INSTALLED BY: SUNLAND UTILITIES LTD

SAG IN SANITARY SERVICE WAS REPAIRED BY JOE ROBERTS CONSTRUCTION LTD. AUGUST 2017

WATER HISTORY:

DATE INSTALLED: JULY 2012

INSTALLED BY: SUNLAND UTILITIES LTD.

STORM HISTORY:

DATE INSTALLED: JULY 2012

INSTALLED BY: SUNLAND UTILITIES LTD.

SAG IN STORM SERVICE WAS REPAIRED BY JOE ROBERTS CONSTRUCTION LTD. AUGUST 2017