

City of Prince George

HISTORY SHEET

PID: 029333997

Scale: 1:500

Legal: LOT 4

D.L.: 4045

PLAN: EPP32590

Address: 4605 AVTAR PL

Sanitary Connection:# SIZE: 100mmØ MATERIAL: PVC INV. 604.37m CONNECTED

Water Connection:# SIZE: 19mmØ MATERIAL: copper INV. 604.21m METER

Storm Connection:# SIZE: 100mmØ MATERIAL: PVC INV. 604.37m CONNECTED

Cash Receipt No's: WATER SANITARY STORM

CURB FROM PROPERTY LINE 5m PAVEMENT WIDTH 10m

B.C. HYDRO 75mm DB2

B.C. TELEPHONE 100mm DB2


TERASEN 42 PROP/P.E.

Information Sheets: REFERENCE DRAWINGS L&M ENGINEERING LIMITED JOB NO. 1256-04-04

Comments: CS CURB STOP CO CLEAN OUT SDW WATER SERVICE STORM SERVICE SANITARY SERVICE HYDRO SERVICE CABLE SERVICE TELECOMMUNICATIONS GAS ELECTRICAL

THE INFORMATION CONTAINED HEREIN IS FOR INTERNAL USE ONLY.

NOT TO BE RELIED UPON UNLESS CONFIRMED BY THE SITE INSPECTION AND/OR INVESTIGATION

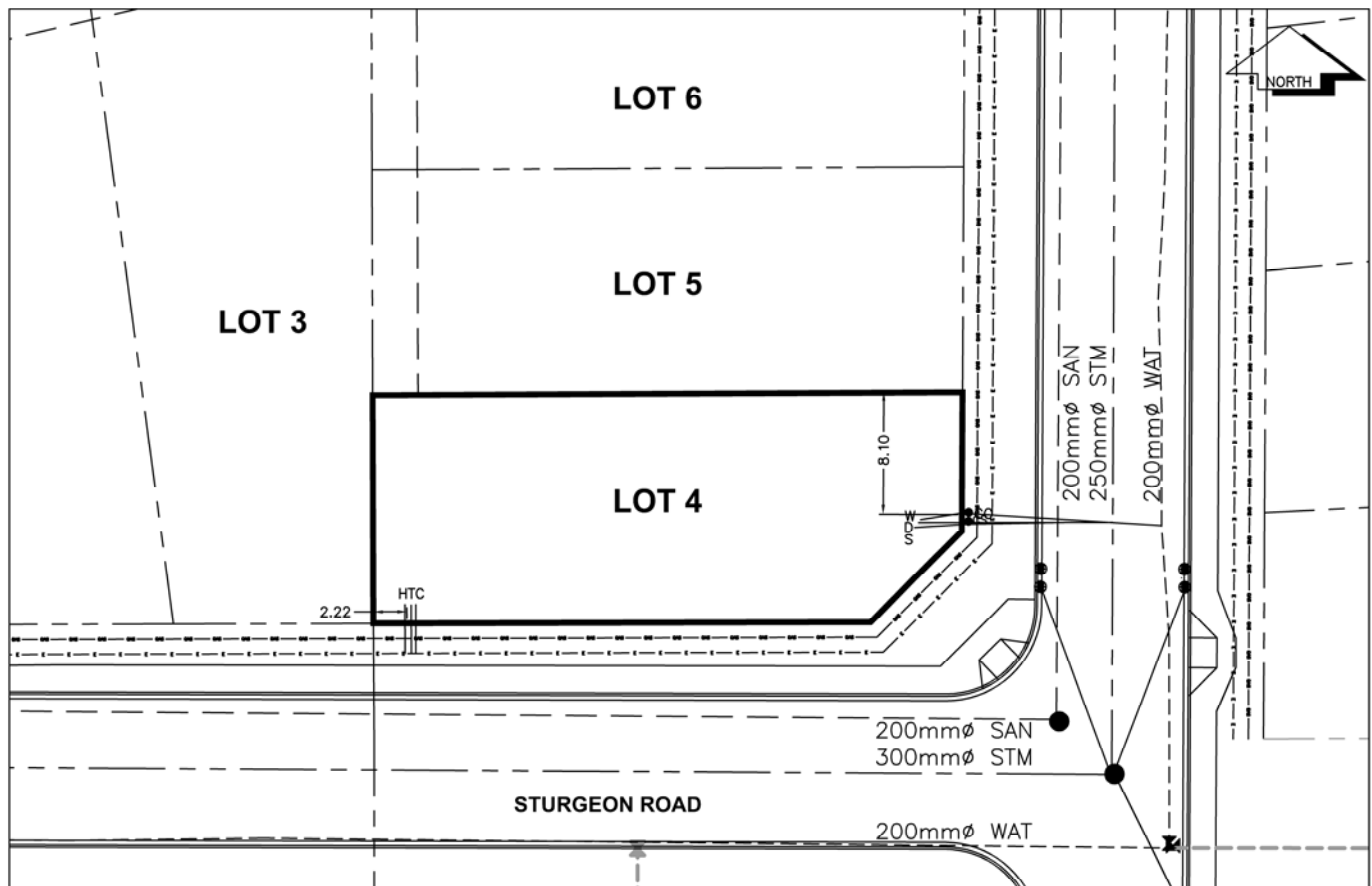

SANITARY, STORM & WATER SERVICE INVERTS	SANITARY	WATER	STORM
1. Distance from San. M.H. <u>5246</u> toward San. M.H. <u>5247</u> to lot service connection point is:	13m	N/A	N/A
1a.Distance from Stm. M.H. <u>3809</u> toward Stm. M.H. <u>3810</u> to lot service connection point is:	N/A	N/A	16m
2. Main Size at connection point is	200mm	200mm	250mm
3. Invert of main at conn. stub point is	604.16m	603.79m	604.07m
4. Invert at service end is	604.46m	604.31m	604.46m
5. Cut at property line in meters	2.34m	2.61m	2.35m
6. Survey Date: OCT 2012 Book Ref.:1256-04-04 By:ALLNORTH			

SANITARY HISTORY:

Installed By: Klein and Sons Construction

WATER HISTORY:

Installed By: Klein and Sons Construction

STORM HISTORY:

Installed By: Klein and Sons Construction