
City of Prince George HISTORY SHEET

PID: 02933400	029334004 Scale: 1:500									
Legal: LOT 5						D.L.: 4045		PLAN:	EPP32590	
Address: 4611 AVTAR I	PL									
Sanitary Connection:#		SIZE:	100mmØ	MATERIAL:	PVC		INV.	605.16m	CONNE	CTED
Water Connection:#		SIZE:	19mmØ	MATERIAL:	copper		INV.	604.63m	METER	
Storm Connection:#		SIZE	100mmØ	MATERIAL	PVC		INV.	605.18m	CONNE	CTED
Cash Receipt No's:			WATER		SANITA	RY			STORM	
CURB FROM PROPERTY LINE 5m							PAVEMENT WIDTH 10m			
B.C. HYDRO	75mm DB2									
B.C. TELEPHONE	100mm DB2									
TERASEN	42 PROP/P.E.									
Information Sheets:	REFERENCE DRAWINGS L&M ENGINEERING LIMITED JOB NO. 1256-04-04									
Comments:	CS CURB STOP									

THE INFORMATION CONTAINED HEREIN IS FOR INTERNAL USE ONLY. NOT TO BE RELIED UPON UNLESS CONFIRMED BY THE SITE INSPECTION AND/OR INVESTIGATION

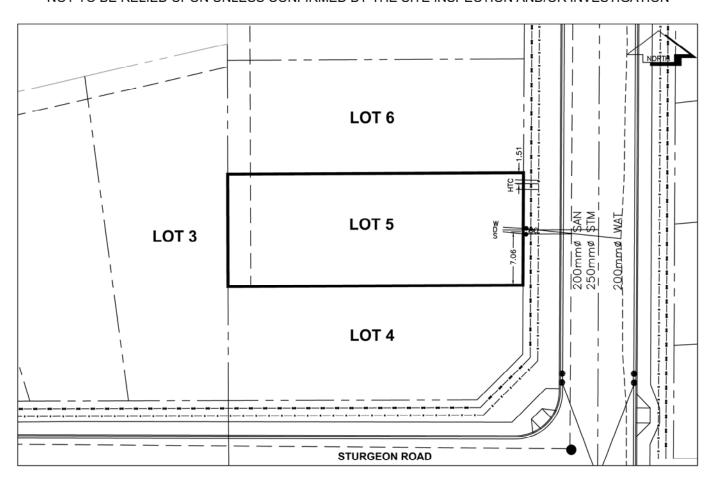

SANITARY, STORM & WATER SERVICE INVERTS	SANITARY	WATER	STORM
1. Distance from San. M.H. <u>5246</u> toward San. M.H. <u>5247</u> to lot service connection point is:	28m	N/A	N/A
1a.Distance from Stm. M.H. 3809 toward Stm. M.H. 3810 to lot service connection point is:	N/A	N/A	32m
2. Main Size at connection point is	200mm	200mm	250mm
3. Invert of main at conn. stub point is	604.80m	604.26m	604.74m
4. Invert at service end is	605.31m	604.71m	605.31m
5. Cut at property line in meters	2.22m	2.87m	2.23m
6. Survey Date: OCT 2012 Book Ref.:1256-04-04 By:ALLNORTH			
SANITARY HISTORY:			
Installed By: Klein and Sons Construction			
WATER HISTORY:			
Installed By: Klein and Sons Construction			
The state of the s			
STORM HISTORY:			
Installed By: Klein and Sons Construction			