

# City of Prince George

## HISTORY SHEET

PID: 029334012

Scale: 1:500

Legal: LOT 6

D.L.: 4045

PLAN: EPP32590

Address: 4619 AVTAR PL

Sanitary Connection:#	SIZE:	100mmØ	MATERIAL:	PVC	INV.	605.76m	CONNECTED
-----------------------	-------	--------	-----------	-----	------	---------	-----------

Water Connection:#	SIZE:	19mmØ	MATERIAL:	copper	INV.	605.20m	METER
--------------------	-------	-------	-----------	--------	------	---------	-------

Storm Connection:#	SIZE	100mmØ	MATERIAL	PVC	INV.	605.78m	CONNECTED
--------------------	------	--------	----------	-----	------	---------	-----------

Cash Receipt No's:	WATER	SANITARY	STORM
--------------------	-------	----------	-------

CURB FROM PROPERTY LINE	5m	PAVEMENT WIDTH	10m
-------------------------	----	----------------	-----

B.C. HYDRO 75mm DB2


B.C. TELEPHONE 100mm DB2

TERASEN 42 PROP/P.E.

Information Sheets: REFERENCE DRAWINGS L&M ENGINEERING LIMITED JOB NO. 1256-04-04

Comments:	CS CURB STOP CO CLEAN OUT	SDW WATER SERVICE STORM SERVICE SANITARY SERVICE	HYDRO SERVICE CABLE SERVICE TELECOMMUNICATIONS	GAS ELECTRICAL
-----------	------------------------------	---	--	-------------------

THE INFORMATION CONTAINED HEREIN IS FOR INTERNAL USE ONLY.  
NOT TO BE RELIED UPON UNLESS CONFIRMED BY THE SITE INSPECTION AND/OR INVESTIGATION

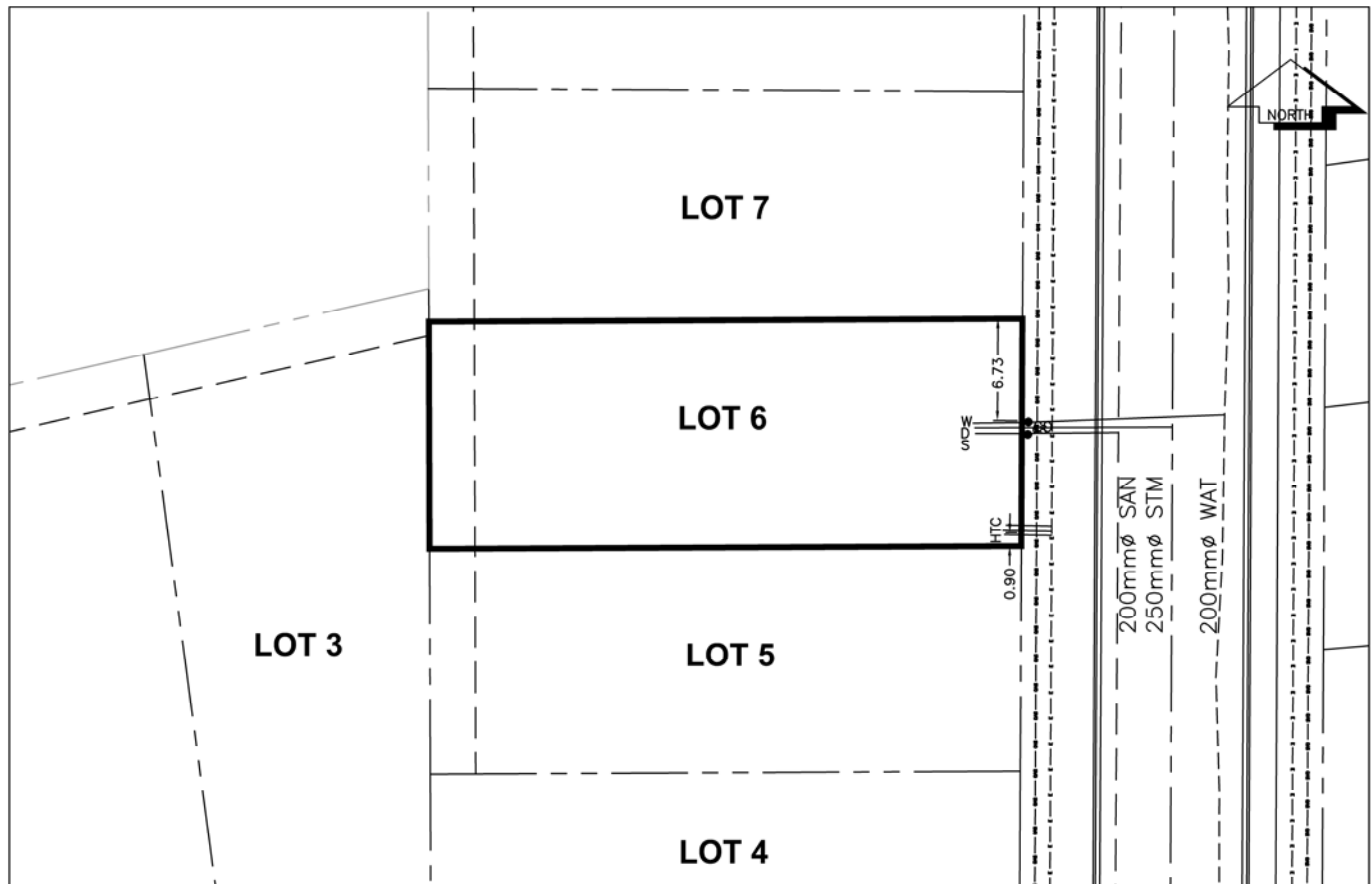

Installed By: Klein and Sons Construction

---

---

Installed By: Klein and Sons Construction

---

---

Installed By: Klein and Sons Construction

---

---

