

# City of Prince George

## HISTORY SHEET

PID: 029334047

Scale: 1:500

Legal: LOT 9

D.L.: 4045

PLAN: EPP32590

Address: 4631 AVTAR PL

Sanitary Connection:# SIZE: 100mmØ MATERIAL: PVC INV. 607.68m CONNECTED

Water Connection:# SIZE: 19mmØ MATERIAL: copper INV. 607.12m METER

Storm Connection:# SIZE: 100mmØ MATERIAL: PVC INV. 607.71m CONNECTED

Cash Receipt No's: WATER SANITARY STORM

CURB FROM PROPERTY LINE 5m PAVEMENT WIDTH 10m

B.C. HYDRO 75mm DB2

B.C. TELEPHONE 100mm DB2


TERASEN 42 PROP/P.E.

Information Sheets: REFERENCE DRAWINGS L&M ENGINEERING LIMITED JOB NO. 1256-04-04

Comments: CS CURB STOP SDW WATER SERVICE HYDRO SERVICE GAS  
CO CLEAN OUT STORM SERVICE CABLE SERVICE  
SANITARY SERVICE TELECOMMUNICATIONS ELECTRICAL

THE INFORMATION CONTAINED HEREIN IS FOR INTERNAL USE ONLY.

NOT TO BE RELIED UPON UNLESS CONFIRMED BY THE SITE INSPECTION AND/OR INVESTIGATION

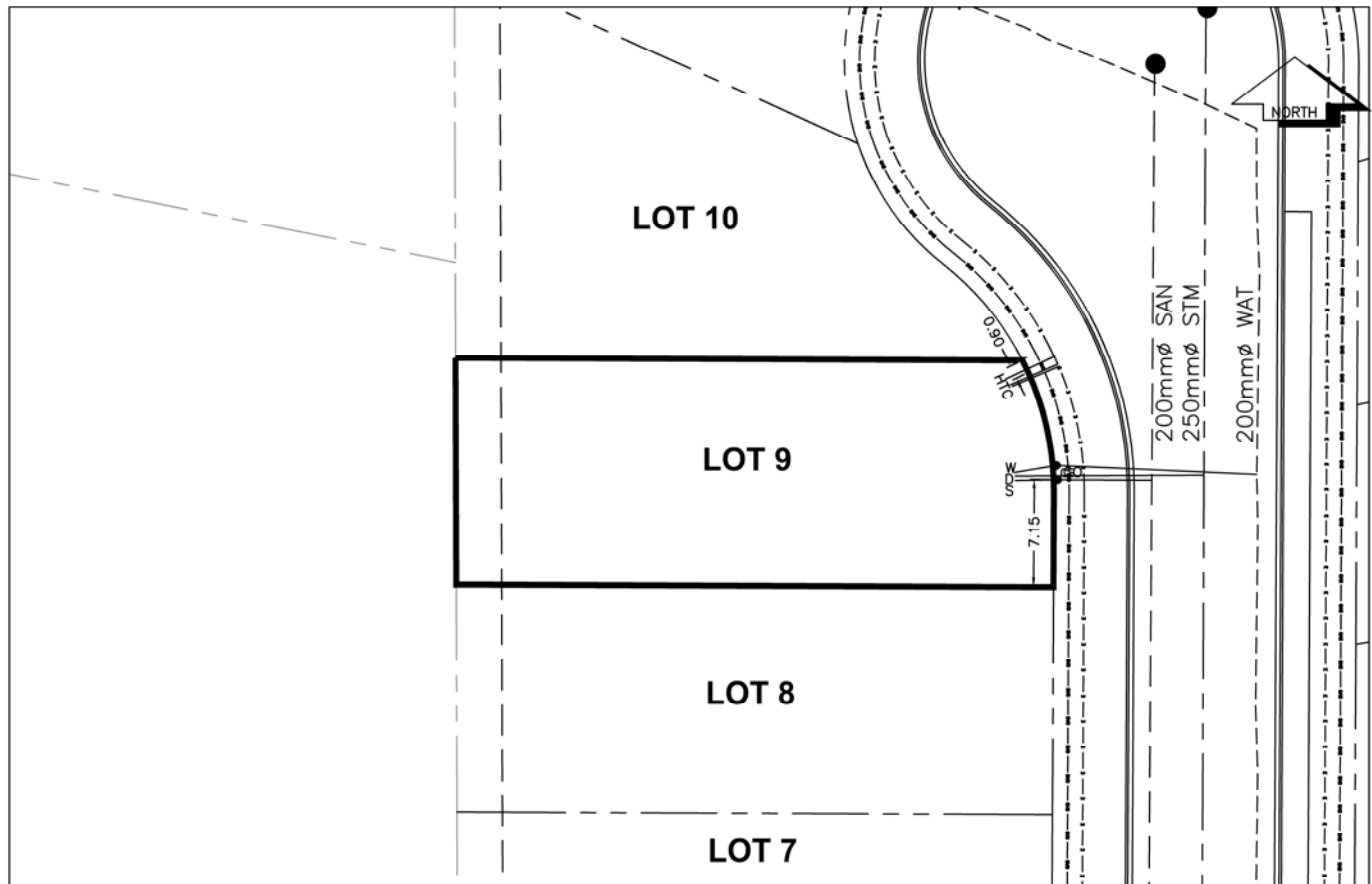

Installed By: Klein and Sons Construction

---

---

Installed By: Klein and Sons Construction

---

---

Installed By: Klein and Sons Construction