

# City of Prince George

## HISTORY SHEET

PID: 029334063

Scale: 1:500

Legal: LOT 11

D.L.: 4045

PLAN: EPP32590

Address: 4643 AVTAR PL

Sanitary Connection:#	SIZE:	100mmØ	MATERIAL:	PVC	INV.	609.20m	CONNECTED
-----------------------	-------	--------	-----------	-----	------	---------	-----------

Water Connection:#	SIZE:	19mmØ	MATERIAL:	copper	INV.	608.72m	METER
--------------------	-------	-------	-----------	--------	------	---------	-------

Storm Connection:#	SIZE	100mmØ	MATERIAL	PVC	INV.	609.27m	CONNECTED
--------------------	------	--------	----------	-----	------	---------	-----------

Cash Receipt No's:	WATER	SANITARY	STORM
--------------------	-------	----------	-------

CURB FROM PROPERTY LINE	5m	PAVEMENT WIDTH	10m
-------------------------	----	----------------	-----

B.C. HYDRO	75mm DB2
------------	----------

B.C. TELEPHONE	100mm DB2
----------------	-----------


TERASEN	42 PROP/P.E.
---------	--------------

Information Sheets: REFERENCE DRAWINGS L&M ENGINEERING LIMITED JOB NO. 1256-04-04

Comments:	CS <sub>o</sub> CURB STOP	CO CLEAN OUT	SDW	WATER SERVICE	STORM SERVICE	SANITARY SERVICE	HYDRO SERVICE	CABLE SERVICE	TELECOMMUNICATIONS	GAS	ELECTRICAL
-----------	---------------------------	--------------	-----	---------------	---------------	------------------	---------------	---------------	--------------------	-----	------------

THE INFORMATION CONTAINED HEREIN IS FOR INTERNAL USE ONLY.

NOT TO BE RELIED UPON UNLESS CONFIRMED BY THE SITE INSPECTION AND/OR INVESTIGATION

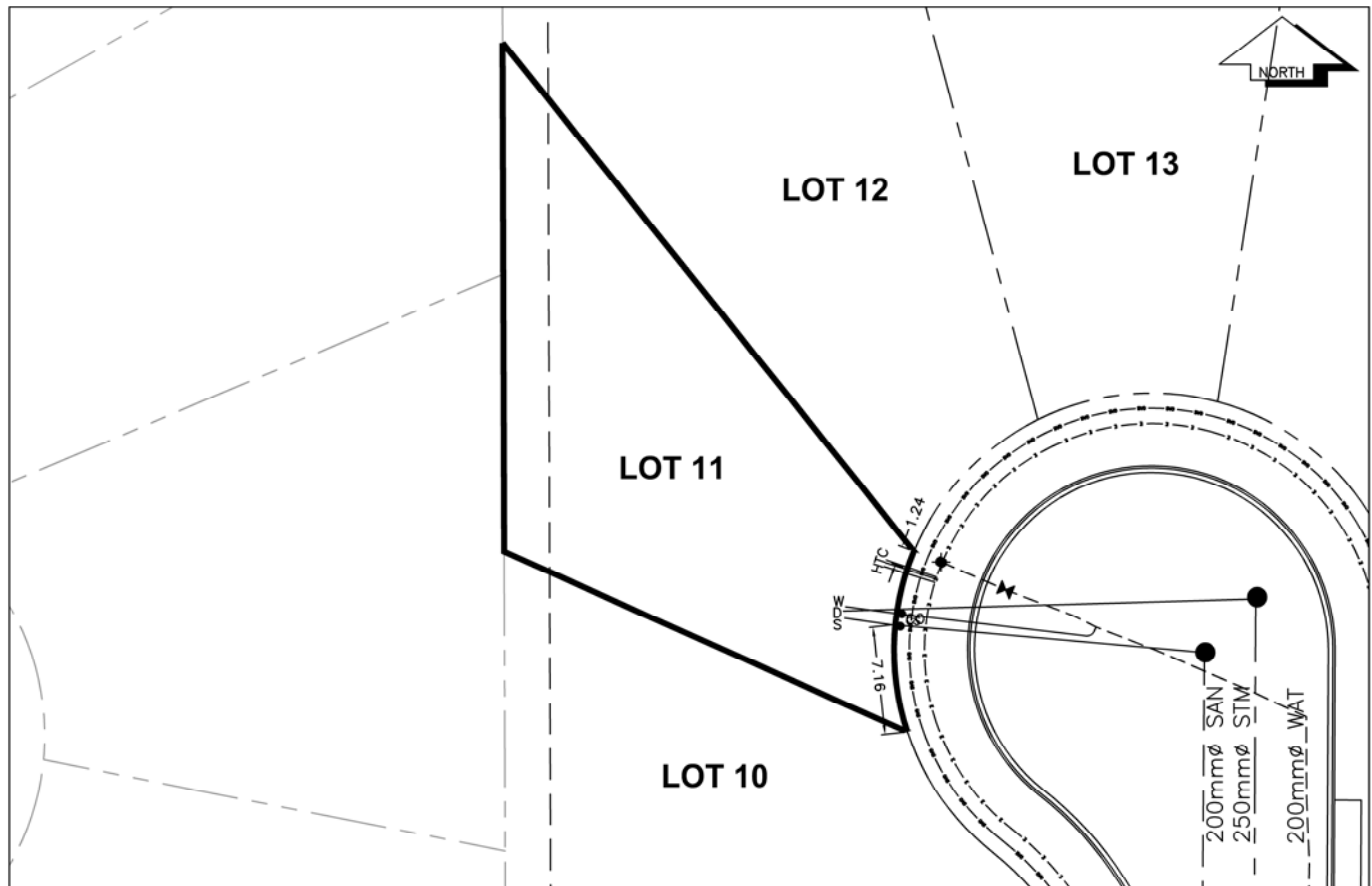

Installed By: Klein and Sons Construction

---

---

Installed By: Klein and Sons Construction

---

---

Installed By: Klein and Sons Construction